

Gidw.

PROJECT Phase II SHEET _____ OF _____


SUBJECT _____ DATE 5-18-18

JOB NO. 4447

BY Atlas

339 S Pendleton

N →

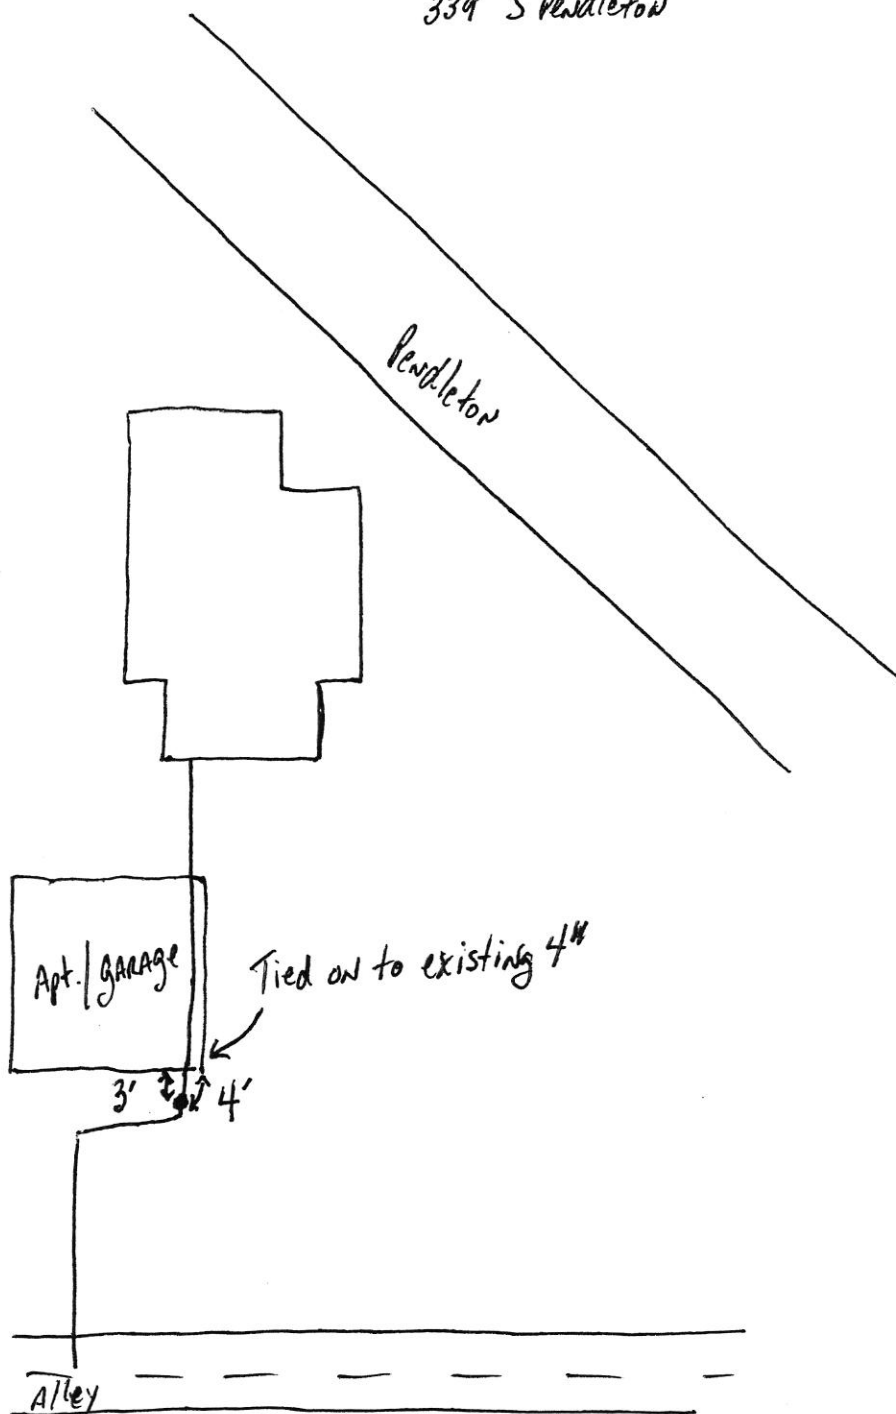

334 S Pendulutan

Sgt Phase II

5-22-18

