

Gidw,

PROJECT Phase II


SUBJECT _____

SHEET _____ OF _____

DATE 12-14-17

JOB NO. 4447


BY ALIAS

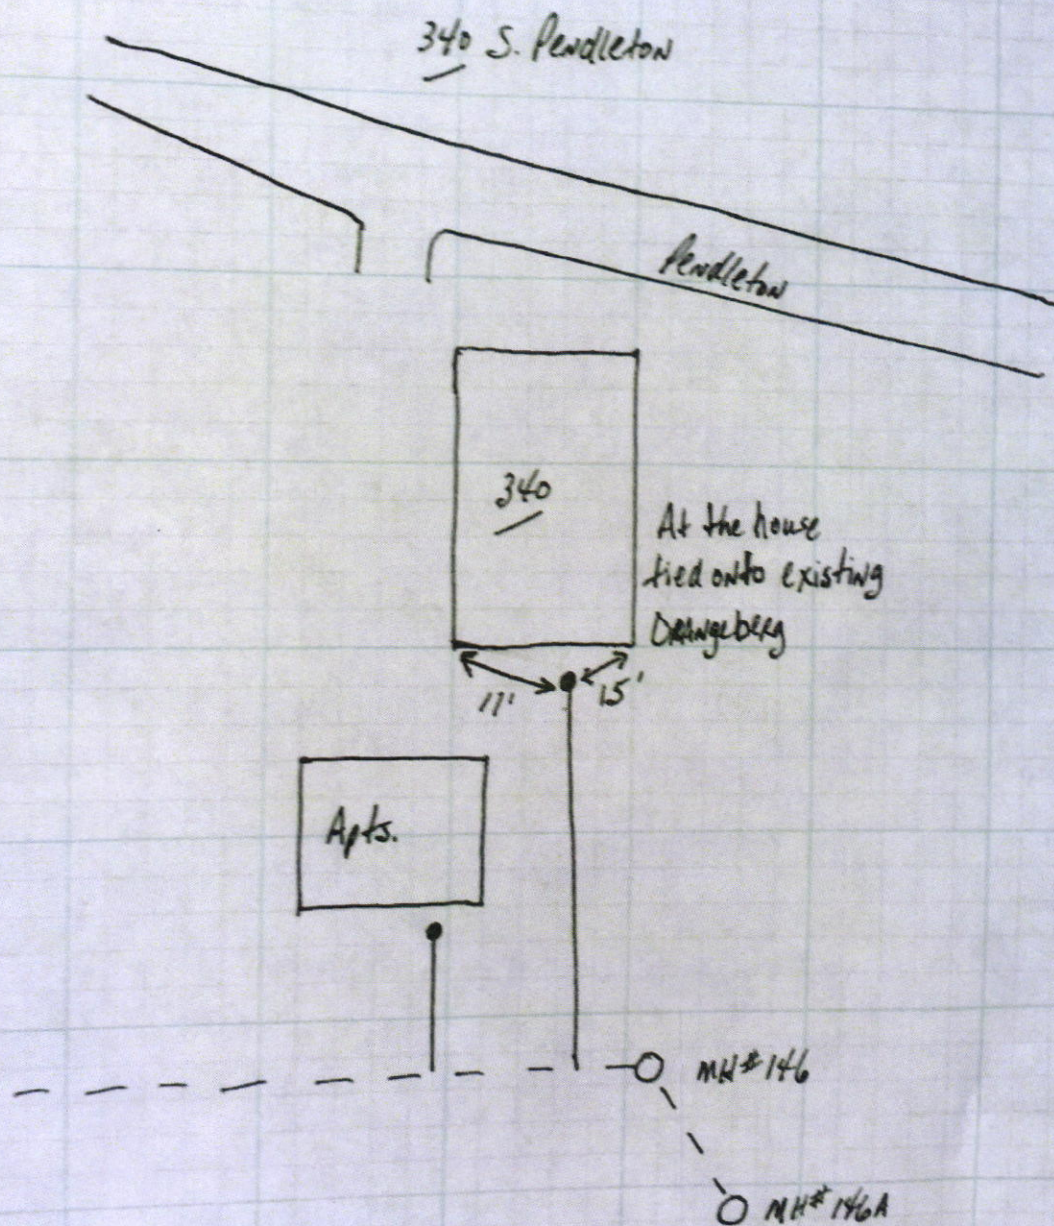

340 S Rendleton Ave

Lateral replacement

S&F Phase II
Dec '17

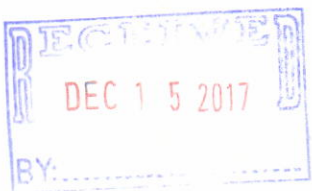

340 S Rendleton Ave

Lateral replacement

SRF Phase II
Dec '17

