

Gidw.

PROJECT Phase II SHEET _____ OF _____


SUBJECT _____ DATE 5-25-18

JOB NO. 4447

BY Atlas

342 S. East

← N

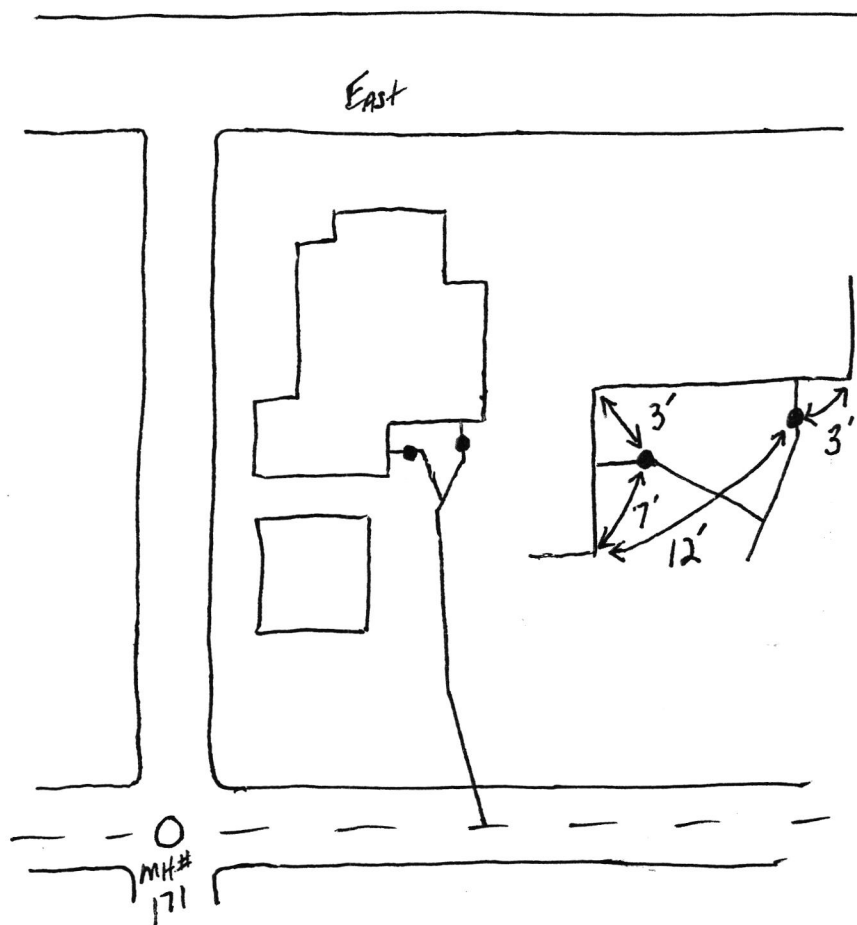

342 S East St

SRF Phase II

5-25-18

