

*Gidw.*

PROJECT

*Phase II*

SHEET

OF

SUBJECT

DATE *5-16-18*


JOB NO. *4447*

BY *Atlas*

*342 S. Broadway*

← *N*

*Broadway*

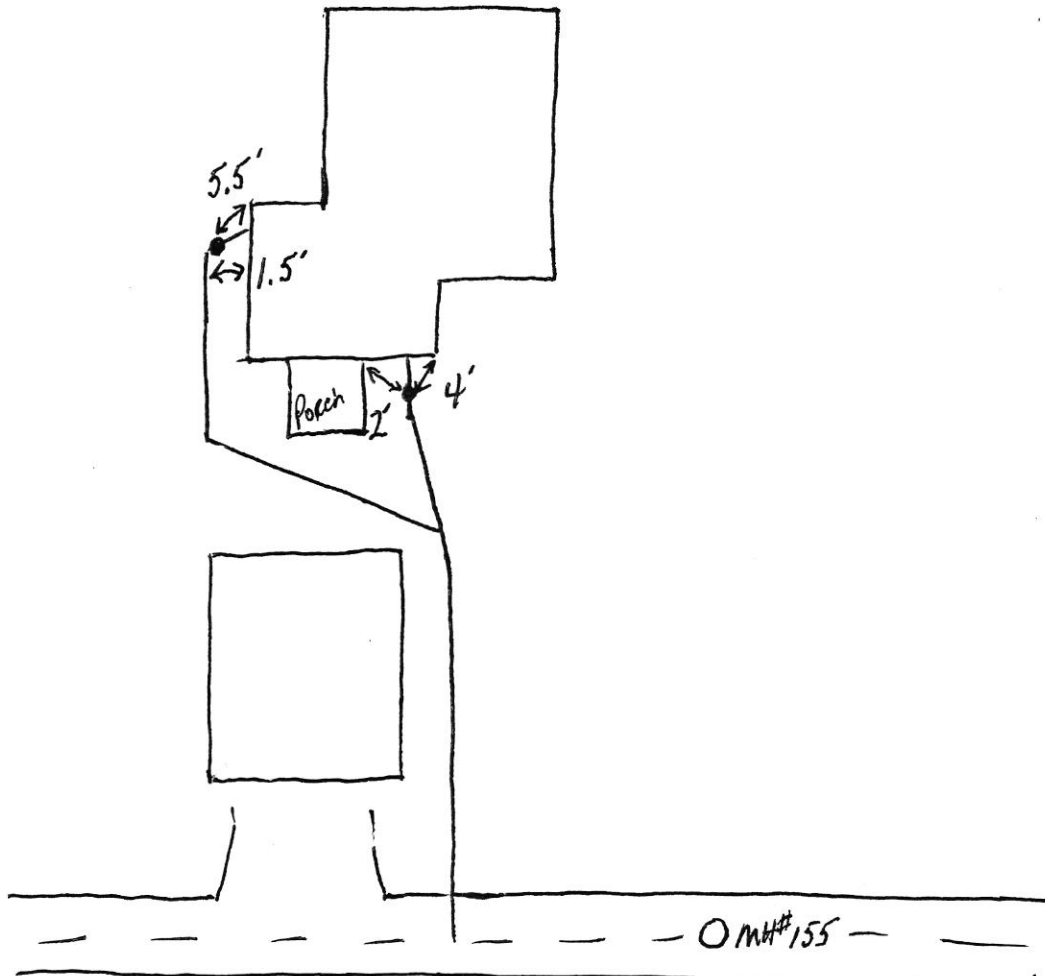



34a S Broadway

B&E Phase II

5.22.18





340 S Broadway

SPT Phase II

5.22.18

