

GLW.

PROJECT Phase II SHEET _____ OF _____

SUBJECT _____ DATE 7-27-18


JOB NO. 4447

BY ALAS

343 Broadway

N →

Broadway

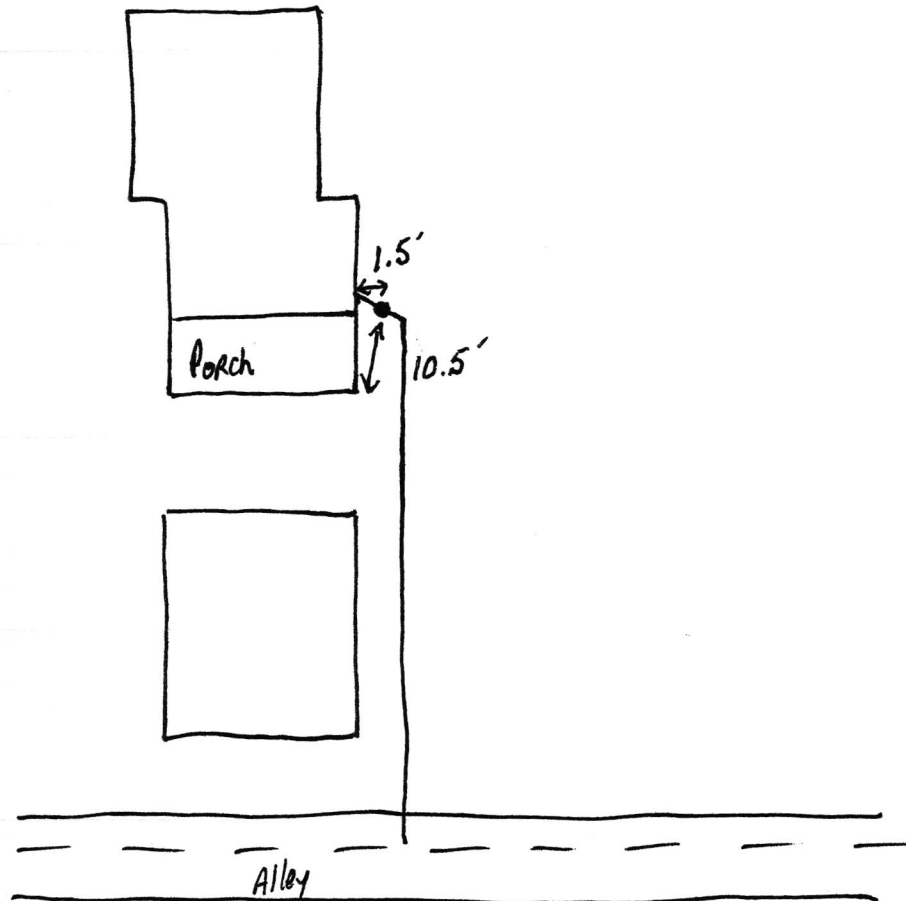



Site Phase II

8.15.18