



## FALL CREEK REGIONAL WASTE DISTRICT

Box 44, Pendleton, Indiana 46064

2-0016360.00

Nº 001164

## APPLICATION FOR SEWER PERMIT

Permit No. \_\_\_\_\_ Date 1-9-86  
 Permit Void 90 days from Date of Issuance  
 Owner Name Phillip Merrill + Linda Sue Toombs  
 Property Address RH Box 470A - Alliance Road  
 Lot # \_\_\_\_\_ P.O. Box 344 Rt. 500 S.  
 Town Anderson, IN Zip Code 46011  
 Phone 649-6441 Water Meter \_\_\_\_\_"  
 \$ 150.00 Tap on Fee Paid  
 \$ 25.00 Inspection fee paid

Application is hereby made for connection to the Fall Creek Regional Waste District Sewer System for the above listed property - Permit Type: Residential ☒, Commercial \_\_\_\_\_, Industrial \_\_\_\_\_, or Governmental/Institutional \_\_\_\_\_. User Information \_\_\_\_\_.

All workmanship and materials shall conform to the standards of the District Ordinance as described in Ordinance 84-2 and 84-3 as amended. Acceptance and approval must be made by the District inspector or his duly authorized representative before backfilling and final connection is made to the main sewer lines. Any violation of applicable regulations will cause all lines and appurtenances in violation to be removed and replaced at the owners expense.

The Fall Creek Regional Waste District is responsible for the inspection, approval of materials, and installation techniques only. All costs for materials and installation and any liabilities resulting from same is the sole responsibility of the property owner.

I have read and fully understand the above provisions and agree to comply by said provisions.

Linda Toombs

APPLICANT(S) SIGNATURE

\*\*\*\*\*

INSPECTOR Don

Date inspected 1/21/86 Approved ☒ Rejected \_\_\_\_\_  
 Reason for rejection \_\_\_\_\_

Date reinspected \_\_\_\_\_ Approved \_\_\_\_\_ Rejected \_\_\_\_\_


## Notes:

Size Pipe 6 "Type Pipe P.V.C.Basement Yes \_\_\_\_\_ No ☒Sump Pump Yes \_\_\_\_\_ No ☒Downspout to Ground Yes ☒ No \_\_\_\_\_

? Septic Tank Pumped &amp; filled Yes \_\_\_\_\_ No \_\_\_\_\_

Contractor LeRoy RLP

Special Conditions \_\_\_\_\_

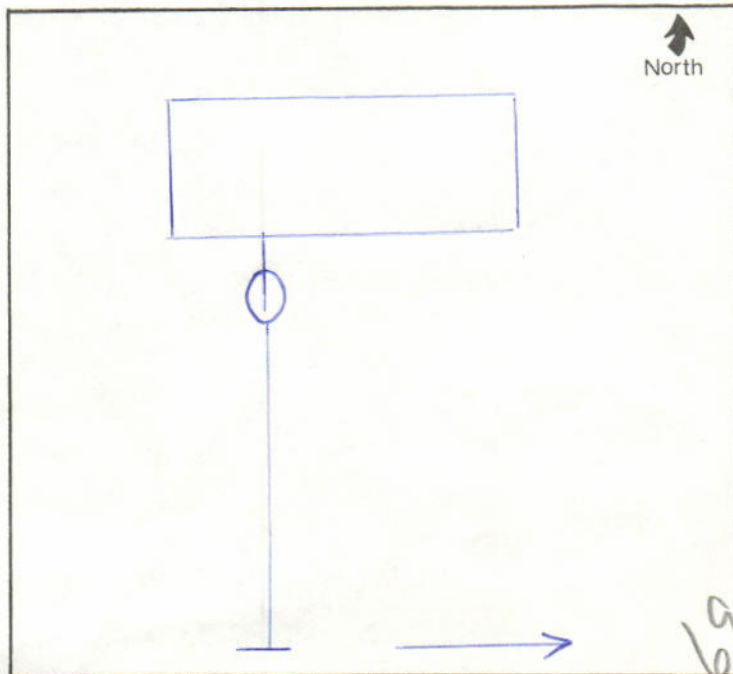

did not find acc