8-12176.00

## Fall Creek Regional Waste District 9378 S 650 W, P.O. Box 59, Pendleton, IN 46064 765-778-7544 Agreement for Sanitary Sewer Service

This Agreement made and entered into this  $\underline{\partial}_{u}$  day of  $\underline{\mathcal{M}_{u}$ , 20, between Fall Creek Regional Waste District ("District") and <u>D.R. Horton/Westport Homes</u> ("Applicant") regarding the provision of sanitary sewer service, and the assignment of capacity in and connection to, the District's facilities for the premises located at <u>Carrick Glen Lot 126</u>

Street Address:346 lemerich In Rendle to
--


Now therefore, the parties, in consideration of the mutual promises set out in this Agreement, the receipt and sufficiency of which is hereby acknowledged, agree as follows:


- 1. The Applicant agrees that all workmanship and materials shall conform to all District ordinances and the District's construction standards. District must accept and approve all work and materials before backfilling and final connection is made to the sewer mains. Any violation of this provision will cause all lines and appurtenances in violation to be removed and replaced at the Applicant's expense.
- 2. The District shall have the right to enter upon the Applicant's premises at all reasonable times to inspect, repair, or replace any equipment used in connection with the District's service or which has an impact on said service.
- 3. The Applicant shall be responsible for all monthly user rates, capacity charges, and tap fees. The failure to pay any rate charge or fee may result in a lien against the property and/or the termination of service to the property, the cost of which will be borne by Applicant, including, but not limited to, all attorney's fees and collection costs.
- 4. The District shall not be responsible for any damages as a result of any failure to supply service unless said damages are due to default, neglect or culpability on the part of the District.
- 5. If there is an available sanitary sewer within three hundred (300) feet of the property line, the property owner shall be required to connect to the District's sanitary sewer system.
- 6. The Applicant and District agree that the provision of sanitary sewer service touches and concerns the property and the terms of this Agreement bind the District and Applicant and their heirs, executors, administrators, personal representatives, successors, agents, attorneys, assigns, designees, and transferees.

The parties hereto have read and fully understand the above provisions and agree to comply with said provisions.

FALL CREEK REGIONAL WASTE DISTRICT	APPLICANT
Signature	Signature
STATE OF INDIANA )	
) SS: COUNTY OF MADISON )	
SUBSCRIBED and sworn to before me this	day of, 20
My Commission Expires:	Signature
	Printed
	Notary Public Resident of County
Inspector <u>liqle</u> Date Inspected <u>6/29/22</u> Reason for Rejecton	
Date Reinspected A	Approved Rejected
Notes: Size Pipe	
Basement <u>Yes</u>	
Sump Pump <u>Yes (No)</u>	North
Downspout to Ground Yes No	
Septic Tank Pumped & Filled Yes No	
Contractor Wills Exu.	Drawine
Special Conditions Existing Home	0
Existing Home New Construction	+
	A Dictorio
	+ PICIOFE
	attached

#7724

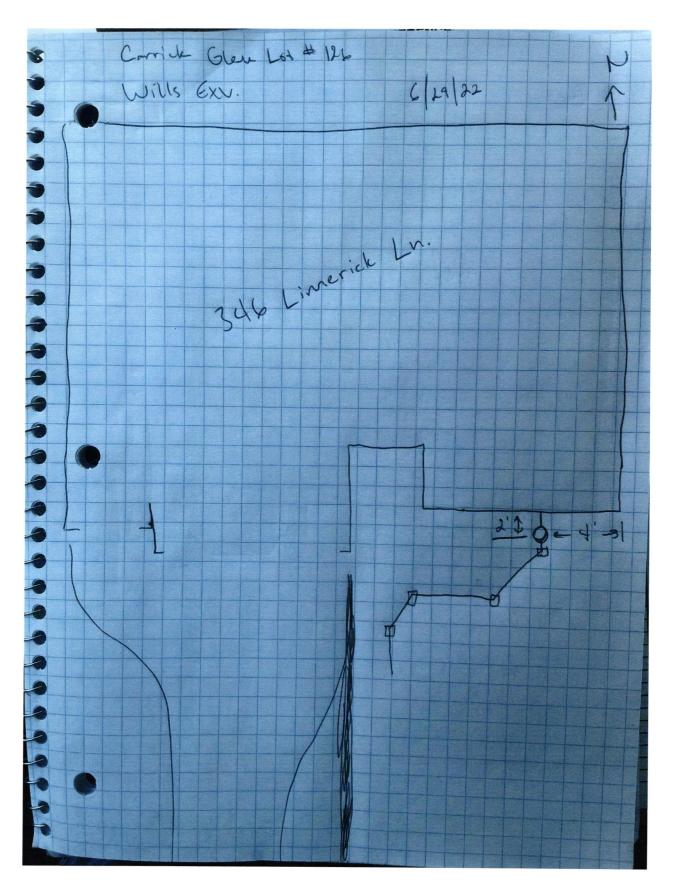

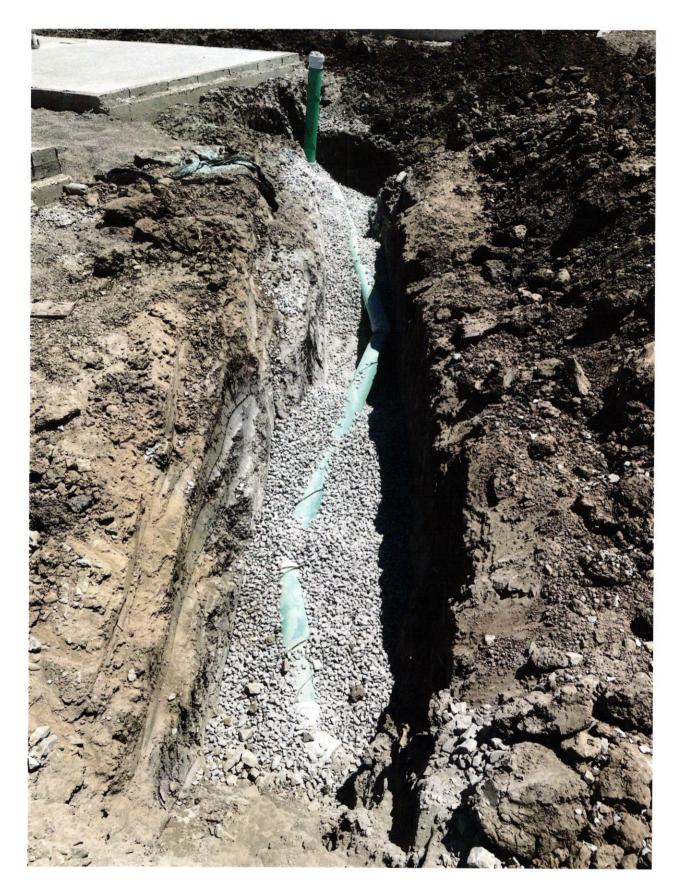

RHORTON BAL	JP Morgan Chase Bank, N.A. Syracuse, NY		Check Number 1462067	
DRH Inc. Controlled Disb 1341 Horton Circle Arlington, TX 76011		<u>50-937</u> 213	Date	Amount
			03/02/22	\$*****760.00
ington, 1x 76011		2720128	Void after 6 r	months from date of issue
같은 가슴 (現응 가는 가슴감 20) 가슴	그 옷은 걸었던 것 같은 것은 것은 것이 같이 것			1 1 1 1 1 1 1 1 1 1 1 1 1 1 1 1 1 1 1
SEVEN HUNDRED SIXT	Y AND 00/100 ********************************	******	******	******
SEVEN HUNDRED SIXT	Y AND 00/100 ********************************	******	**********	******
SEVEN HUNDRED SIXT	Y AND 00/100 ********************************	************	**********	*****
Pay To The Order Of:		************	****************	******
Pay To The Order Of: FALL CREEK REGIONA		***********	***********	******
Pay To The Order Of: FALL CREEK REGIONA 9378 SOUTH 650 WEST		************	**********	******
Pay To The Order Of: FALL CREEK REGIONA		***********	***********	.*******

CB 126