

Gidw.

PROJECT Phase II SHEET _____ OF _____


SUBJECT _____ DATE 5-21-18

JOB NO. 4447

BY Atlas

346 S. Broadway


← N

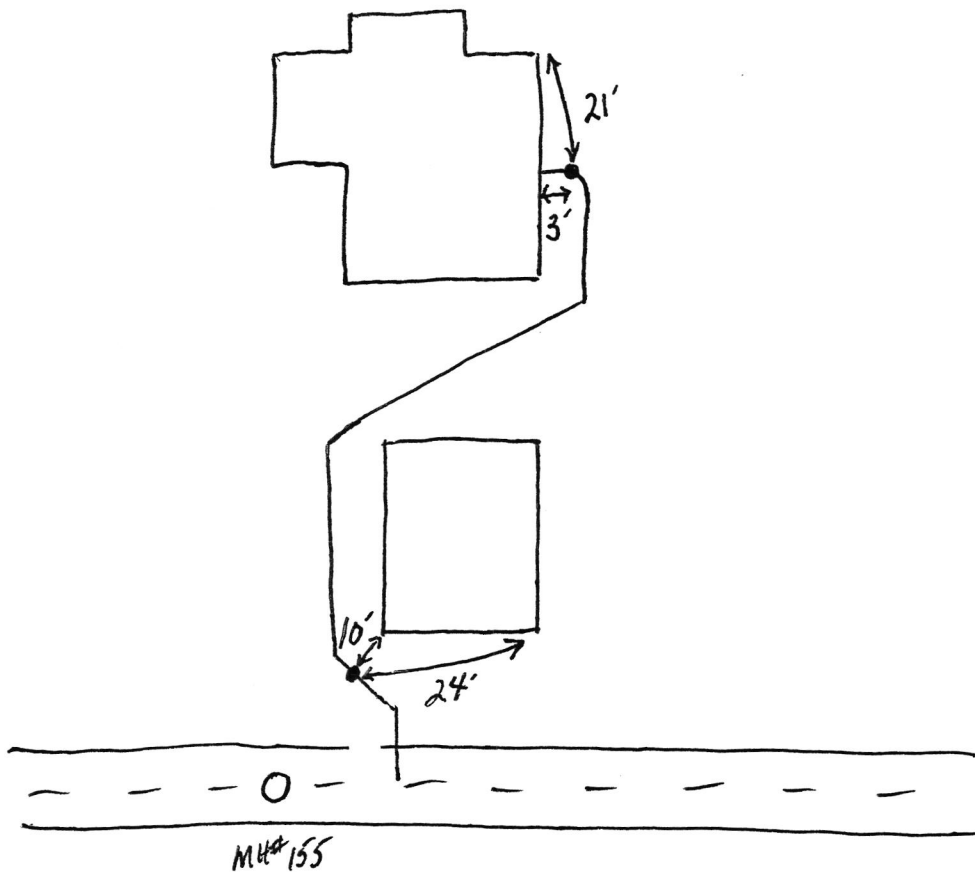

346 S Broadway

SF Phase II

5.22.18

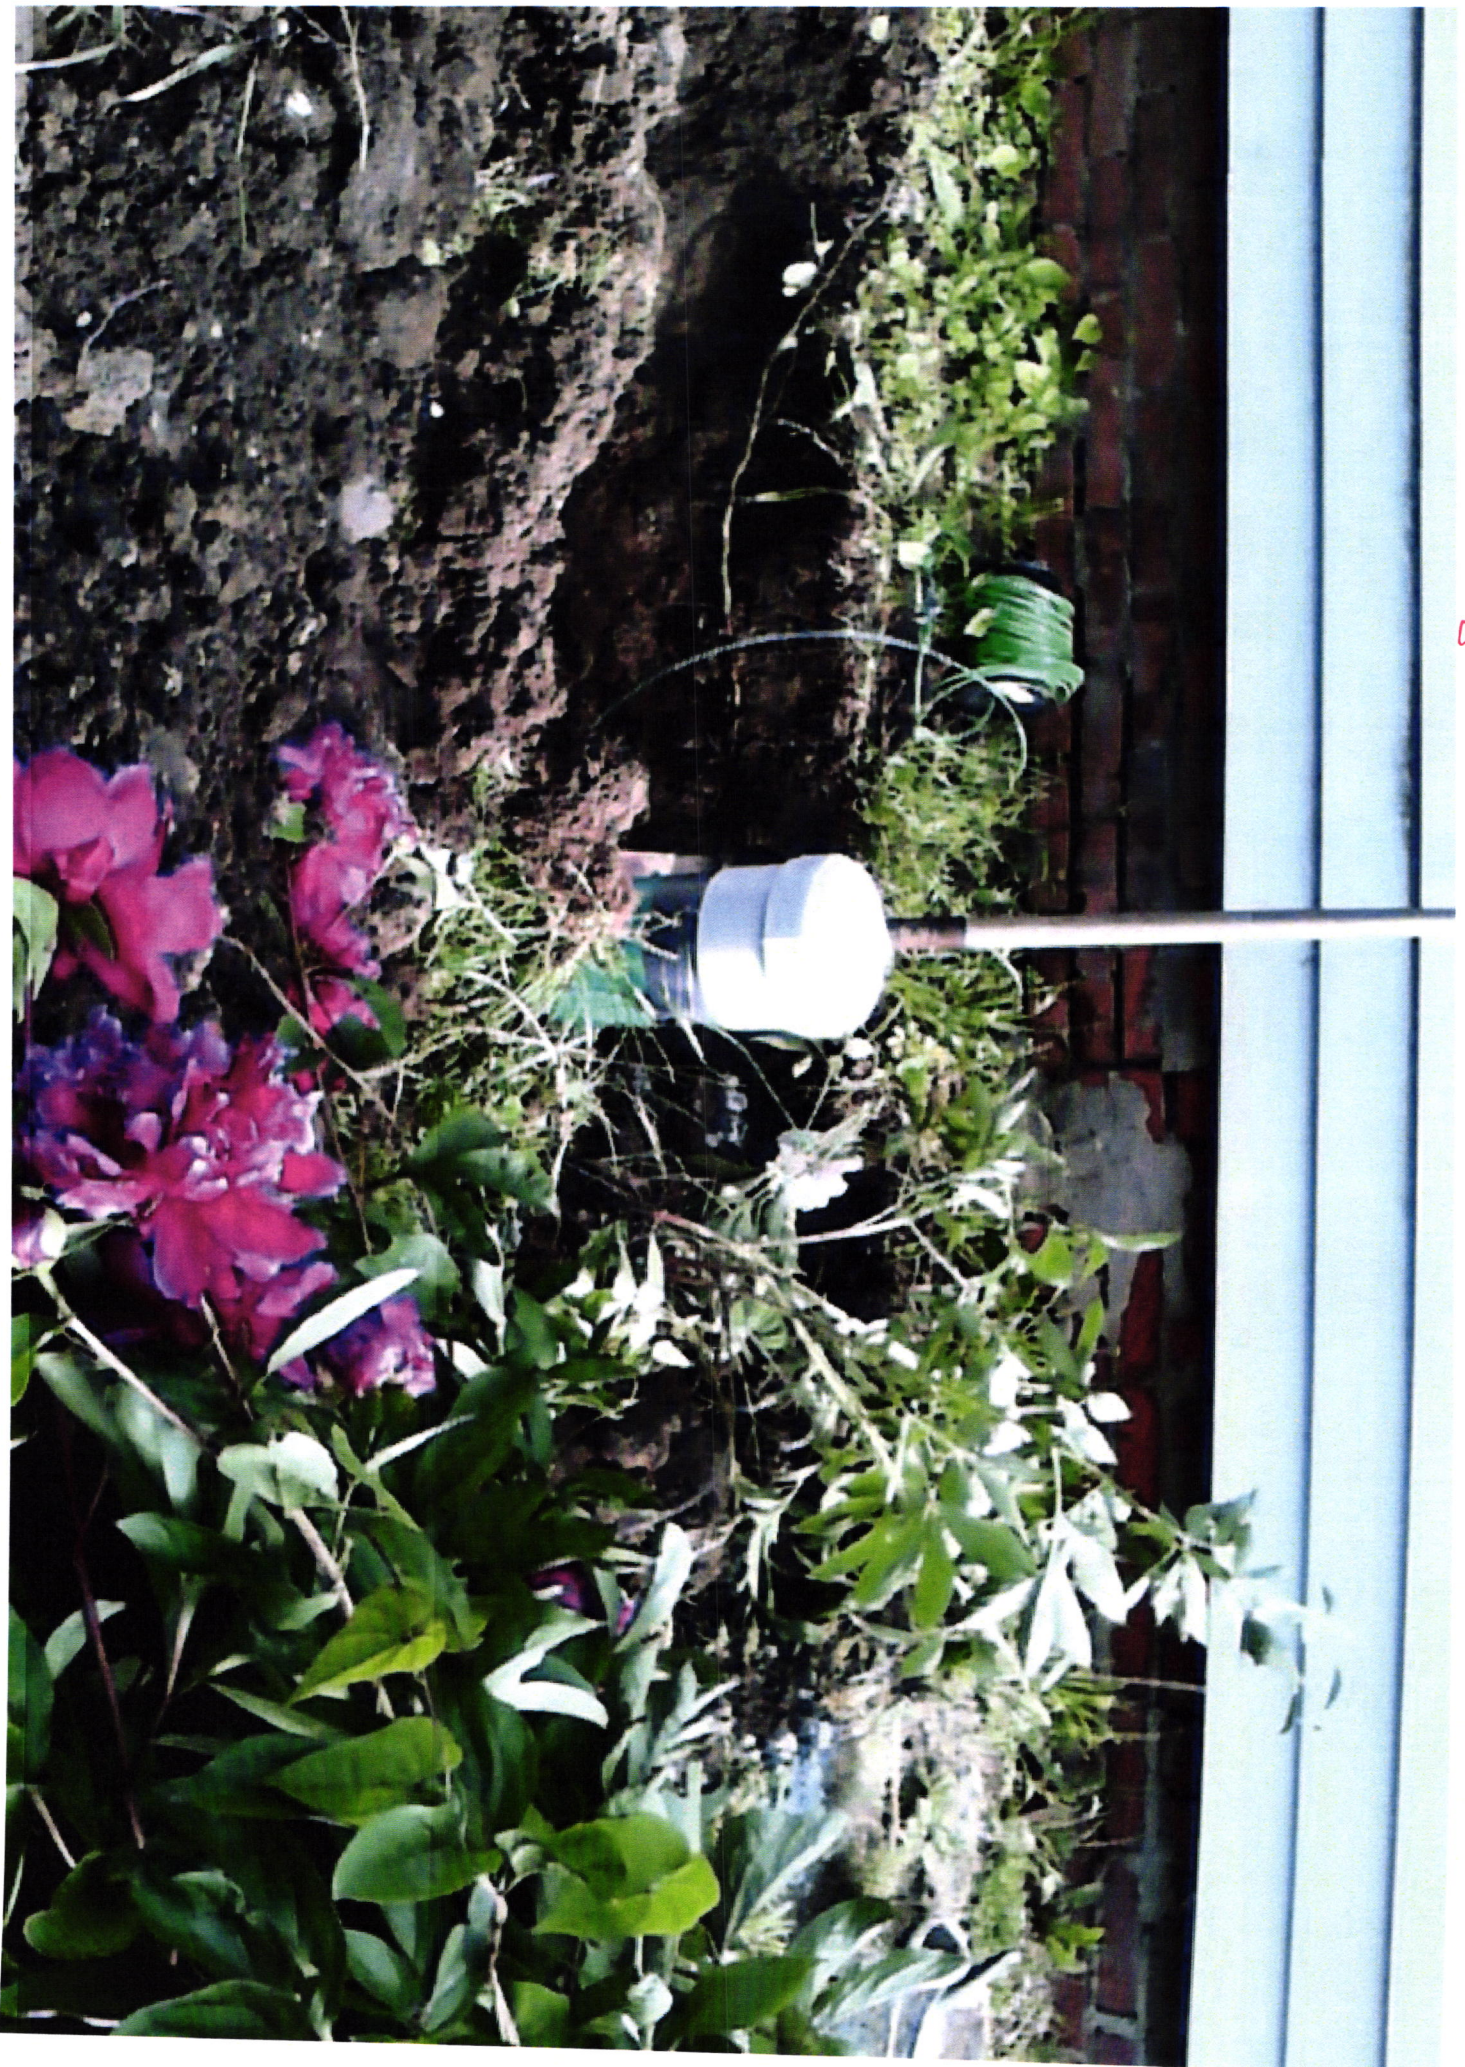

5.22.18

SRP Phase II

3410 S Broadway

