


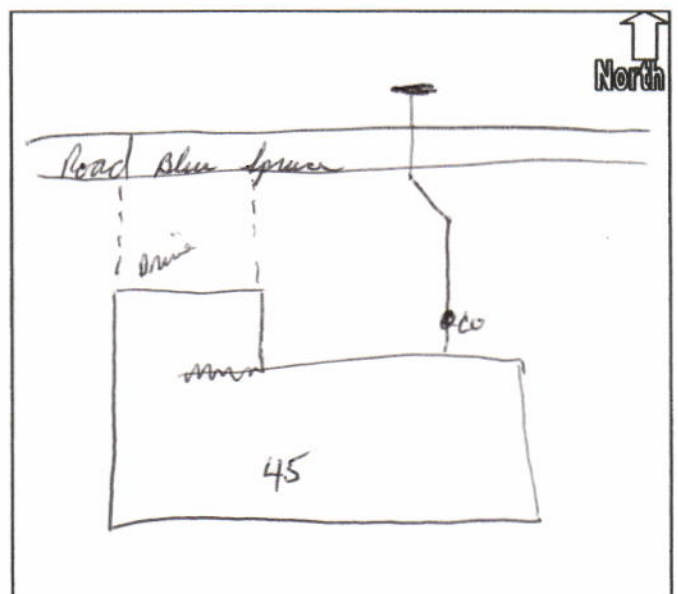

CORONADO RIDGE DEVELOPMENT CORP.

08/01

2981

1350 E 151ST ST
CARMEL, IN 46032

DATE 2-6-04

71-17863

PAY
TO THE
ORDER OF FCRWD

\$ 13,175.00

THIRTEEN THOUSAND ONE HUNDRED SEVENTY FIVE AND 00/100 DOLLARS



OLD NATIONAL BANK

Indianapolis, Indiana • www.oldnational.com

FOR 45,44,93,58,87 SEWER FEES

[Signature]

⑈00298⑈ ⑆0863000⑆2⑆