

Gidw.

PROJECT

Phase II

SHEET

OF

SUBJECT

DATE

8-1-18

JOB NO.

4447


BY

AKS

347 S. BROADWAY

N →

BROADWAY

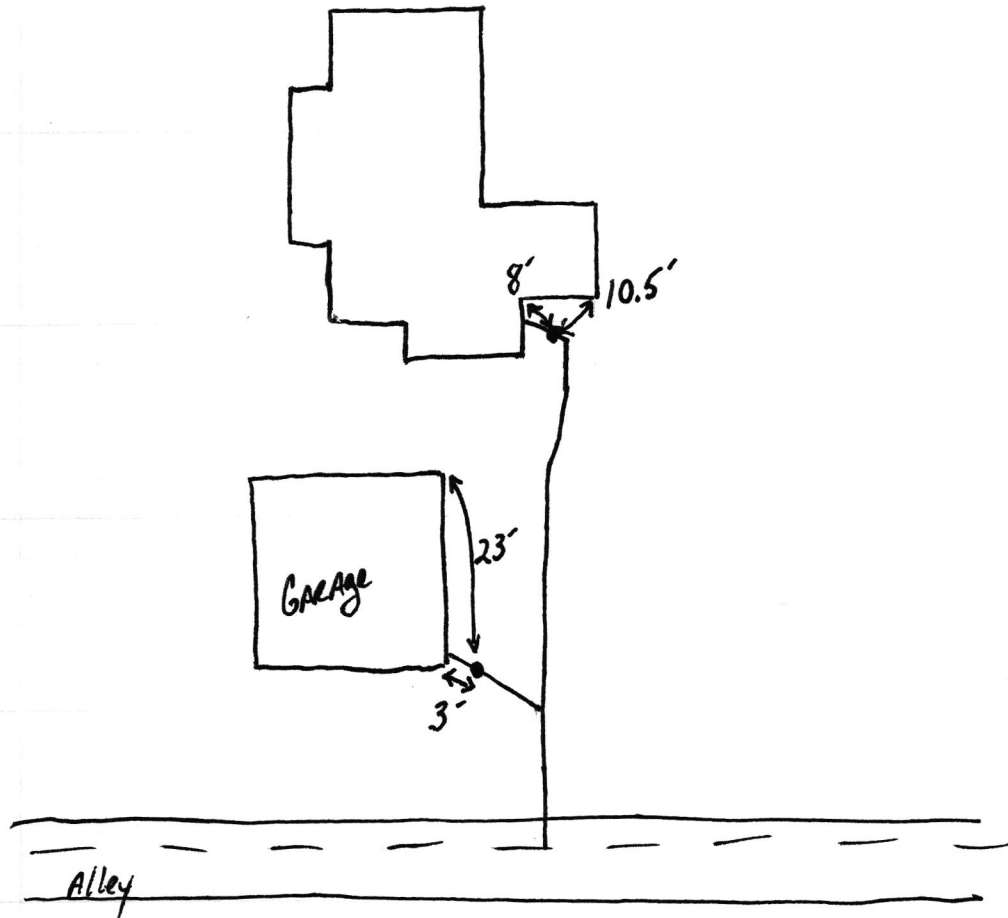

ST 1 - 3 WOODAWAY

SRE Phase II

8-15-18





Survey

Change

Site Phase II

8.15.18