



# FALL CREEK REGIONAL WASTE DISTRICT

Box 44, Pendleton, Indiana 46064

22-23028.00

Nº 001819

## APPLICATION FOR SEWER PERMIT

Permit No. \_\_\_\_\_ Date 11/21/91

Permit Void 90 days from Date of Issuance

Owner Name Casert, Damon

Property Address 349 W U.S. 36

Lot # 1 P.O. Box \_\_\_\_\_

Town Pendleton, IN Zip Code 46064

Phone \_\_\_\_\_ Water Meter \_\_\_\_\_

\$ 2880.00 Tap on Fee Paid

\$ 25.00 Inspection fee paid

Application is hereby made for connection to the Fall Creek Regional Waste District Sewer System for the above listed property - Permit Type: Residential X, Commercial \_\_\_\_\_, Industrial \_\_\_\_\_, or Governmental/Institutional \_\_\_\_\_. User Information \_\_\_\_\_

All workmanship and materials shall conform to the standards of the District Ordinance as described in Ordinance 84-2 and 84-3 as amended. Acceptance and approval must be made by the District inspector or his duly authorized representative before backfilling and final connection is made to the main sewer lines. Any violation of applicable regulations will cause all lines and appurtenances in violation to be removed and replaced at the owners expense.

The Fall Creek Regional Waste District is responsible for the inspection, approval of materials, and installation techniques only. All costs for materials and installation and any liabilities resulting from same is the sole responsibility of the property owner.

I have read and fully understand the above provisions and agree to comply by said provisions.

X Damon Casert By Kenneth Mayall  
APPLICANT(S) SIGNATURE

\*\*\*\*\*


INSPECTOR Tim

Date inspected 2-7-92 Approved ✓ Rejected \_\_\_\_\_

Reason for rejection \_\_\_\_\_

Date reinspected \_\_\_\_\_ Approved \_\_\_\_\_ Rejected \_\_\_\_\_

Notes:  
Size Pipe 4"  
Type Pipe SDR 35  
Basement Yes \_\_\_\_\_ No ✓  
Sump Pump Yes \_\_\_\_\_ No ✓  
Downspout to Ground Yes ✓ No \_\_\_\_\_  
Septic Tank Pumped & filled Yes ✓ No \_\_\_\_\_  
Contractor SELF  
Special Conditions \_\_\_\_\_

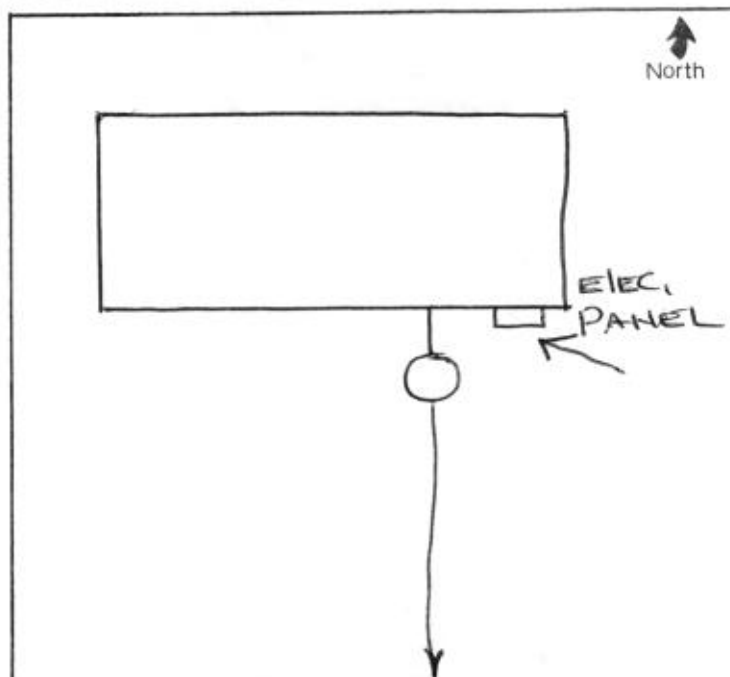

# FALL CREEK REGIONAL WASTE DISTRICT

Box 44, Pendleton, Indiana 46054

330-11-00



W-001818

INSTRUCTIONS FOR THE USER

11/21/91

11/21/91

Name: George, Thomas  
 Address: 314 W. 11th St.  
 City: Pendleton  
 State: IN  
 Zip: 46054  
 Phone: 330-11-00  
 Fax: 330-11-00

I, the undersigned, hereby certify that the information furnished herein is true and correct to the best of my knowledge and belief.  
 Signature: George, Thomas  
 Date: 11/21/91

The Fall Creek Regional Waste District is responsible for the collection, transport, and disposal of solid waste. The District is not responsible for the collection, transport, and disposal of hazardous waste. The District is not responsible for the collection, transport, and disposal of radioactive waste. The District is not responsible for the collection, transport, and disposal of flammable, combustible, or toxic waste. The District is not responsible for the collection, transport, and disposal of waste that is not solid waste.

The Fall Creek Regional Waste District is responsible for the collection, transport, and disposal of solid waste. The District is not responsible for the collection, transport, and disposal of hazardous waste. The District is not responsible for the collection, transport, and disposal of radioactive waste. The District is not responsible for the collection, transport, and disposal of flammable, combustible, or toxic waste. The District is not responsible for the collection, transport, and disposal of waste that is not solid waste.

I have read and understand the terms and conditions of this agreement and agree to be bound by them.

Signed: George, Thomas  
 Date: 11/21/91

The undersigned hereby certifies that the information furnished herein is true and correct to the best of my knowledge and belief.

Date: 11/21/91  
 Signature: George, Thomas

Title: Owner  
 Address: 314 W. 11th St.

City: Pendleton  
 State: IN  
 Zip: 46054

Phone: 330-11-00  
 Fax: 330-11-00

I have read and understand the terms and conditions of this agreement and agree to be bound by them.

Signed: George, Thomas  
 Date: 11/21/91

Title: Owner  
 Address: 314 W. 11th St.

City: Pendleton  
 State: IN  
 Zip: 46054

Phone: 330-11-00  
 Fax: 330-11-00

I have read and understand the terms and conditions of this agreement and agree to be bound by them.

Signed: George, Thomas  
 Date: 11/21/91

