



FALL CREEK REGIONAL WASTE DISTRICT

9378 S. 650 West PO Box 59
Pendleton, IN 46064-0059 778-7544

APPLICATION FOR SEWER PERMIT

Nº 2468

Date 8-7-97

Permit Void 90 days from Date of Issuance

Owner Name Debra Jean BostonProperty Address 34 E. US 36

Lot # _____ P.O. Box _____

Town Pendleton, IN Zip Code 46064Phone 778-7980 City Water _____ Well _____\$ 700.00 Tap on Fee Paid

\$ _____ Inspection fee paid

Application is hereby made for connection to the Fall Creek Regional Waste District Sewer System for the above listed property - Permit Type: Residential ☒, Commercial _____, Industrial _____, or Governmental/Institutional _____. User Information _____.

All workmanship and materials shall conform to the standards of the District Ordinance as described in Ordinance 84-2 and 84-3 as amended. Acceptance and approval must be made by the District inspector or his duly authorized representative before backfilling and final connection is made to the main sewer lines. Any violation of applicable regulations will cause all lines and appurtenances in violation to be removed and replaced at the owners expense.

The Fall Creek Regional Waste District is responsible for the inspection, approval of materials, and installation techniques only. All costs for materials and installation and any liabilities resulting from same is the sole responsibility of the property owner.

I have read and fully understand the above provisions and agree to comply by said provisions.

APPLICANT(S) SIGNATURE

INSPECTOR RDate inspected 9-14-97 Approved ☒ Rejected _____

Reason for rejection _____

Date reinspected _____ Approved _____ Rejected _____


Notes:

Size Pipe 4"Type Pipe PVCBasement Yes _____ No ☒Sump Pump Yes _____ No ☒Downspout to Ground Yes ☒ No _____Septic Tank Pumped & filled Yes ☒ No _____Contractor Earl Davis

Special Conditions _____

Existing Home ☒

New Construction _____

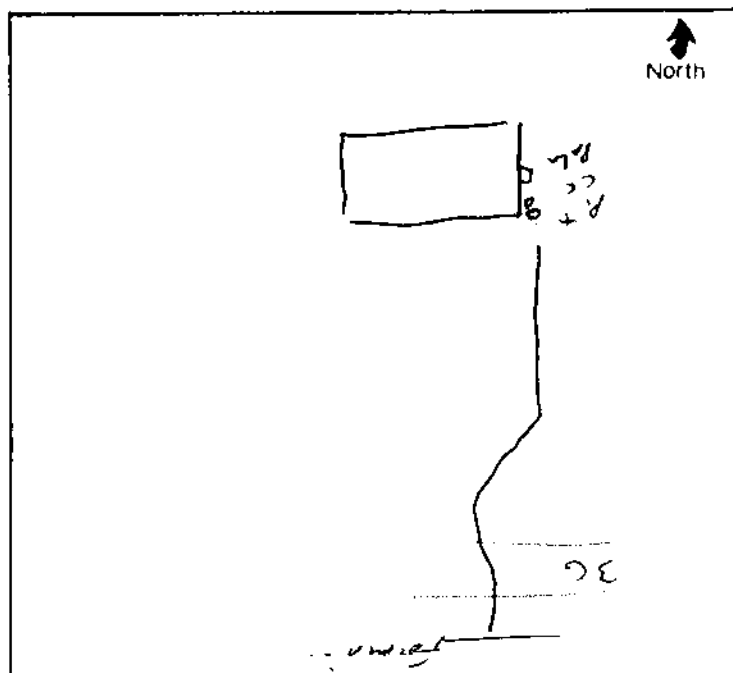

August 8, 1997

Dear Mr. Rowlett,

Thank you for your help!

I still anticipate having
the book-~~up~~ finalized by
the end of August based on
Mr. Davis' phone conversation.

Sincerely,

Peggie Boston



FALL CREEK REGIONAL WASTE DISTRICT

P.O. Box 59 • 9378 S. 650 West • Pendleton, Indiana 46064-0059 • (765) 778-7544

August 11, 1997

Mrs. Teresa K. Hutton
Office Manager

Dear Teresa:

For the record, please handle the following accounts as indicated:

1. Carl Robertson
316 W. US 36
Pendleton, IN 46064
Account # 22-23024.00


Due to Star Financial Bank failing to mail check #A34745, dated January 5, 1995, in the amount of \$700 to the District, we will accept \$700 at this time from Mr. Robertson as payment of his tap fee and the District will not require payment of the Availability/Capacity Fee since this transaction should have occurred prior to March 1, 1996.

2. Debbie Boston
34 E. US 36
Pendleton, IN 46064
Account # 22-23005.00

Mrs. Boston contracted with Davis Excavating in October, 1995 to install her service lateral and attach to our system, however; Mr. Davis has been unable to schedule this job until this month due to a heavy workload.

Since Mrs. Boston has stayed in contact with the District since October, 1995 and has kept current her monthly billings, the District will accept \$700 at this time from Mrs. Boston as payment of her tap fee. In addition, the District will not require payment of the Availability/Capacity Fee since Mrs. Boston contracted with Davis Excavating prior to March 1, 1996.

Sincerely,


J.E. Rowlett