

Gidw.

PROJECT

Phase II

SHEET

OF

SUBJECT

DATE


5-23-18

JOB NO.

4447

BY

AHAS

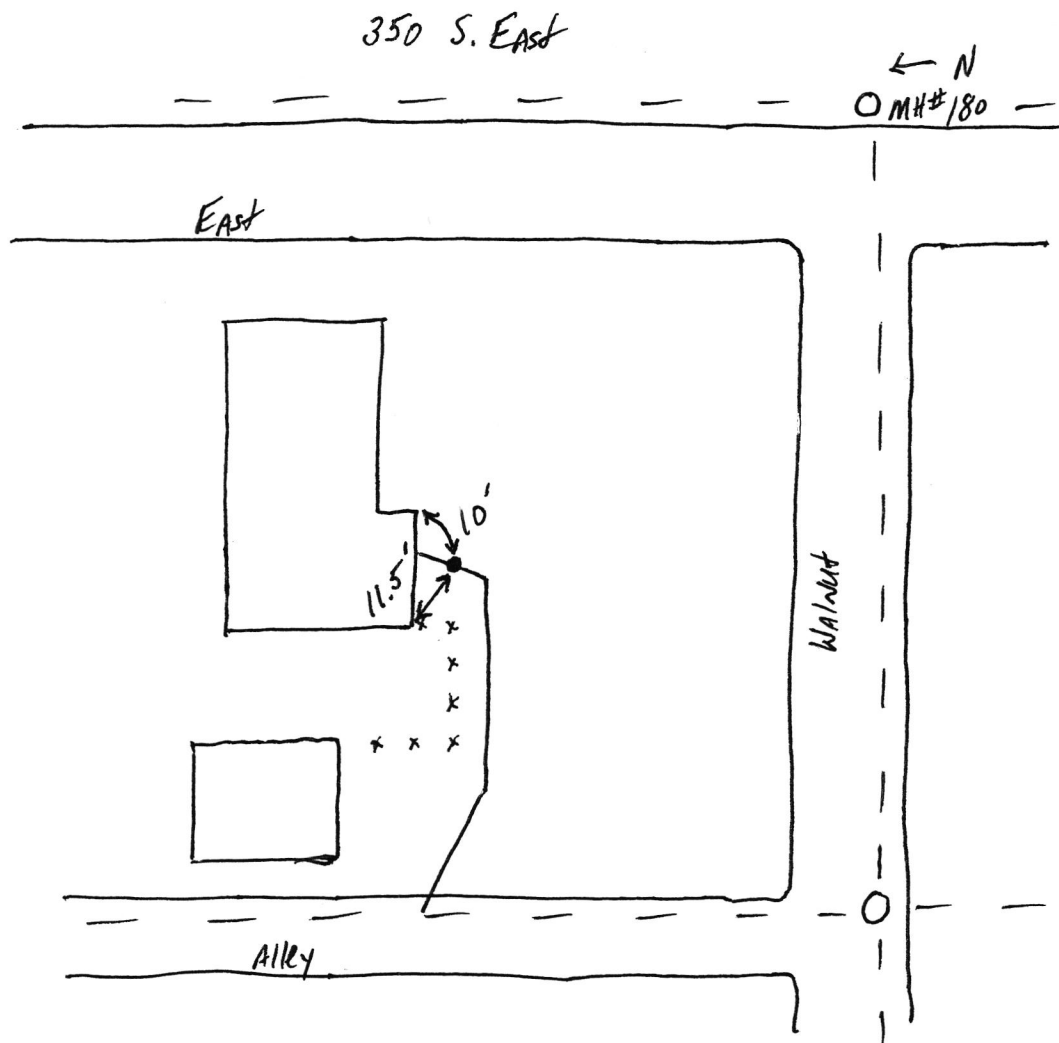

350 S East

SRE Phase II

5.25.18

