

Gidw.

PROJECT

Phase II

SHEET

OF

SUBJECT

DATE

5-23-18

JOB NO.


4447

BY

Atlas

351 S. Pearl

N →

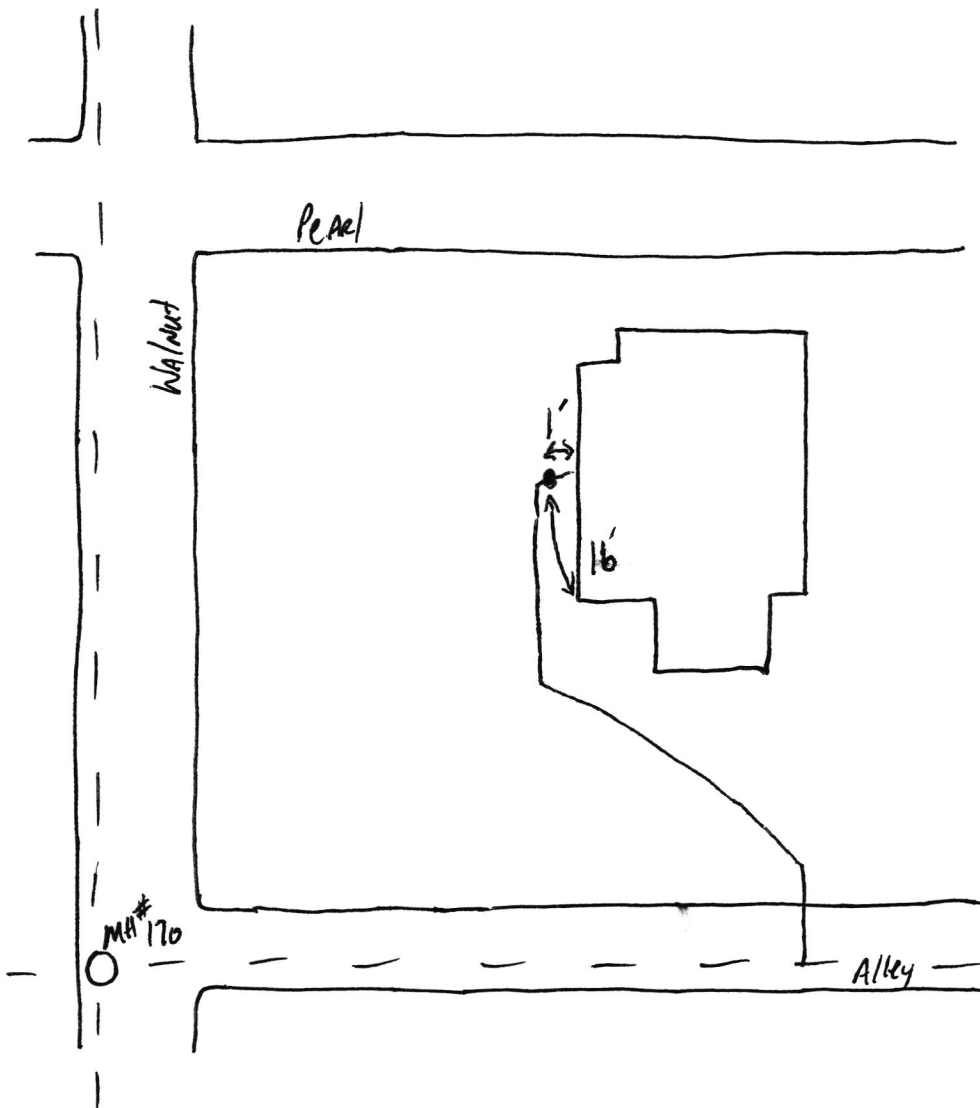



351 S Pearl

SRF Phase II

5.25.18

