

Gidw.

PROJECT Phase II SHEET _____ OF _____


SUBJECT _____ DATE 7-26-18

JOB NO. 4447

BY Atlas

351 S. BROADWAY

N →

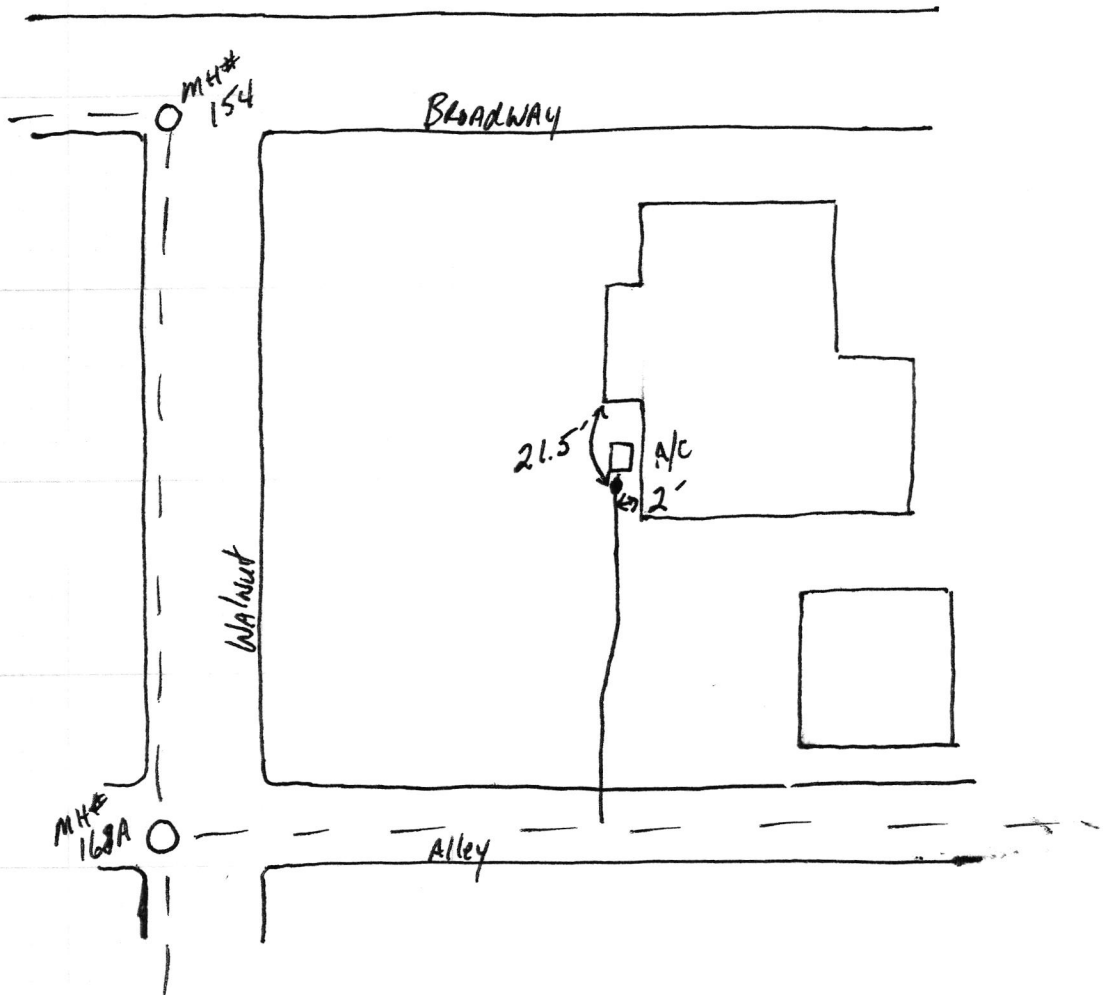

351 S Broadway

SRP Phase II

7.30.18

