

Gidw.

PROJECT Phase II SHEET _____ OF _____

SUBJECT _____ DATE 5-23-18


JOB NO. 4447

BY Atlas

352 S. Broadway

← N

Broadway

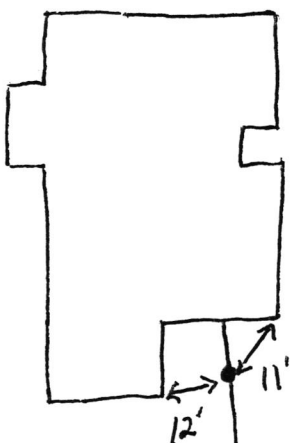

Replaced approx. 60' to the main
due to a belly in the line

352 S Broadway

SRF Phase II

5.25.18

