




PROJECT Phase II SHEET _____ OF _____

SUBJECT _____ DATE 1-19-18

JOB NO. 4447

BY Atlas

354 S. Pearl

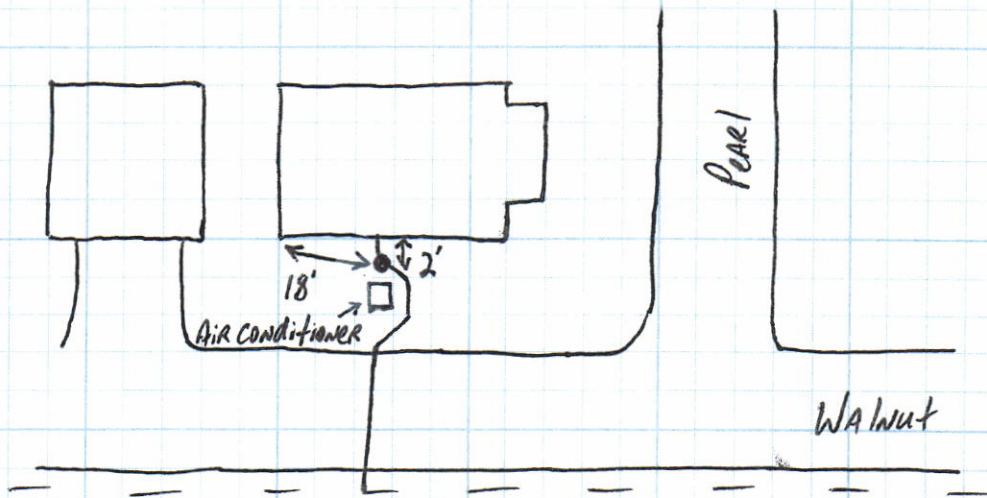

354 S Pearl

SRP Phase II

Jan 2018



354 S Pearl

SRP Phase II

Jan 2018

