

22-23045-00

FALL CREEK REGIONAL WASTE DISTRICT

No 6333

9378 S 650 WEST, P.O. BOX 59, PENDLETON, IN 46064

765-778-7544

AGREEMENT FOR SANITARY SEWER SERVICE

This Agreement made and entered into this 20th day of July, 2008, between FALL CREEK REGIONAL WASTE DISTRICT ("District") and Elizabeth F. Fadely ("Applicant") regarding the provision of sanitary sewer service, and the assignment of capacity in, and connection to, the District's facilities for the premises located at 354 W 75 36 Pendleton 46064.

NOW THEREFORE, the parties, in consideration of the mutual promises set out in this Agreement, the receipt and sufficiency of which is hereby acknowledged, agree as follows:

1. The Applicant agrees that all workmanship and materials shall conform to all District ordinances and the District's construction standards. District must accept and approve all work and materials before backfilling and final connection is made to the sewer mains. Any violation of this provision will cause all lines and appurtenances in violation to be removed and replaced at the Applicant's expense.

2. The District shall have the right to enter upon the Applicant's premises at all reasonable times to inspect, repair, or replace any equipment used in connection with the District's service or which has an impact on said service.

3. The Applicant shall be responsible for all monthly user rates, capacity charges, and tap fees. The failure to pay any rate charge or fee may result in a lien against the property and/or the termination of service to the property, the cost of which will be borne by Applicant, including, but not limited to, all attorney's fees and collection costs.

4. The District shall not be responsible for any damages as a result of any failure to supply service unless said damages are due to default, neglect or culpability on the part of the District.

5. If there is an available sanitary sewer within three hundred (300) feet of the property line, the property owner shall be required to connect to the District's sanitary sewer system.

6. The Applicant and District agree that the provision of sanitary sewer service touches and concerns the property and the terms of this Agreement bind the District and Applicant and their heirs, executors, administrators, personal representatives, successors, agents, attorneys, assigns, designees, and transferees.

The parties hereto have read and fully understand the above provisions and agree to comply with said provisions.

FALL CREEK REGIONAL WASTE DISTRICT

Teresa K. Hutton
Signature

APPLICANT

Elizabeth F. Fadely
Signature

STATE OF INDIANA)
) SS:
COUNTY OF MADISON)

SUBSCRIBED and sworn to before me this 30th day of July, 2008.

My Commission Expires April 19, 2016
Teresa K. Hutton
Notary Public
Madison County, Indiana
A Resident of



Teresa K. Hutton
Signature

Notary Public
Resident of Madison County

INSPECTOR _____ DATE INSPECTED _____ APPROVED _____ REJECTED _____

REASON FOR REJECTION _____

DATE REINSPECTED _____ APPROVED _____ REJECTED _____

NOTES:

SIZE PIPE _____ TYPE PIPE _____

BASEMENT YES _____ NO _____

SUMP PUMP YES _____ NO _____

DOWNSPOUT TO GROUND YES _____ NO _____


SEPTIC TANK PUMPED & FILLED YES _____ NO _____

CONTRACTOR _____

SPECIAL CONDITIONS _____

EXISTING HOME _____

NEW CONSTRUCTION _____

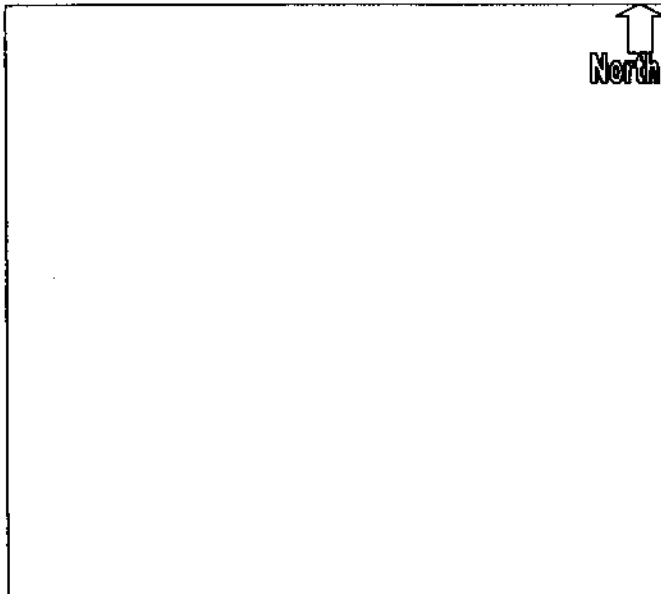

ELIZABETH F. FADELY
ERIKA ELGANZOURI
PH 765-778-3558
354 W. US HIGHWAY 36
PENDLETON, IN 46064

6252

71-7260/2749
BRANCH 1

Pay to the
Order of

FCHW

7-30-08

Date

one thousand nine hundred sixty one

\$1961

Dollars



Features
Detailed on
Back

Madison
County
Federal Credit Union

(765) 644-3623
Anderson, Indiana 46015

For

Fafelt guards

Elizabeth Fadel

⑆ 274972609 ⑆

71 6252

B.L. BROWN
CONSTRUCTION & EXCAVATION, INC.

P.O. BOX 294
PENDLETON, IN 46064-0294
(765) 778-4120

08-963333

MADISON COMMUNITY BANK
71-553749

4301

7/2/03

PAY TO THE
ORDER OF

F.C.F.W.D.

\$2,069.¹⁵/₁₀₀

Two thousand sixty-nine dollars and ¹⁵/₁₀₀ DOLLARS

MEMO:

Brian L Brown


⑈004301⑈ ⑈074905539⑈

SECURITY FEATURES: MICRO PRINT TOP & BOTTOM BORDERS - COLORED PATTERN - ARTIFICIAL WATERMARK ON REVERSE SIDE - MISSING FEATURE INDICATES A COPY

2 grinder units
1 for Liz Gately
1 for Brian Brown property on 300 W

354 vs 36

N ↑

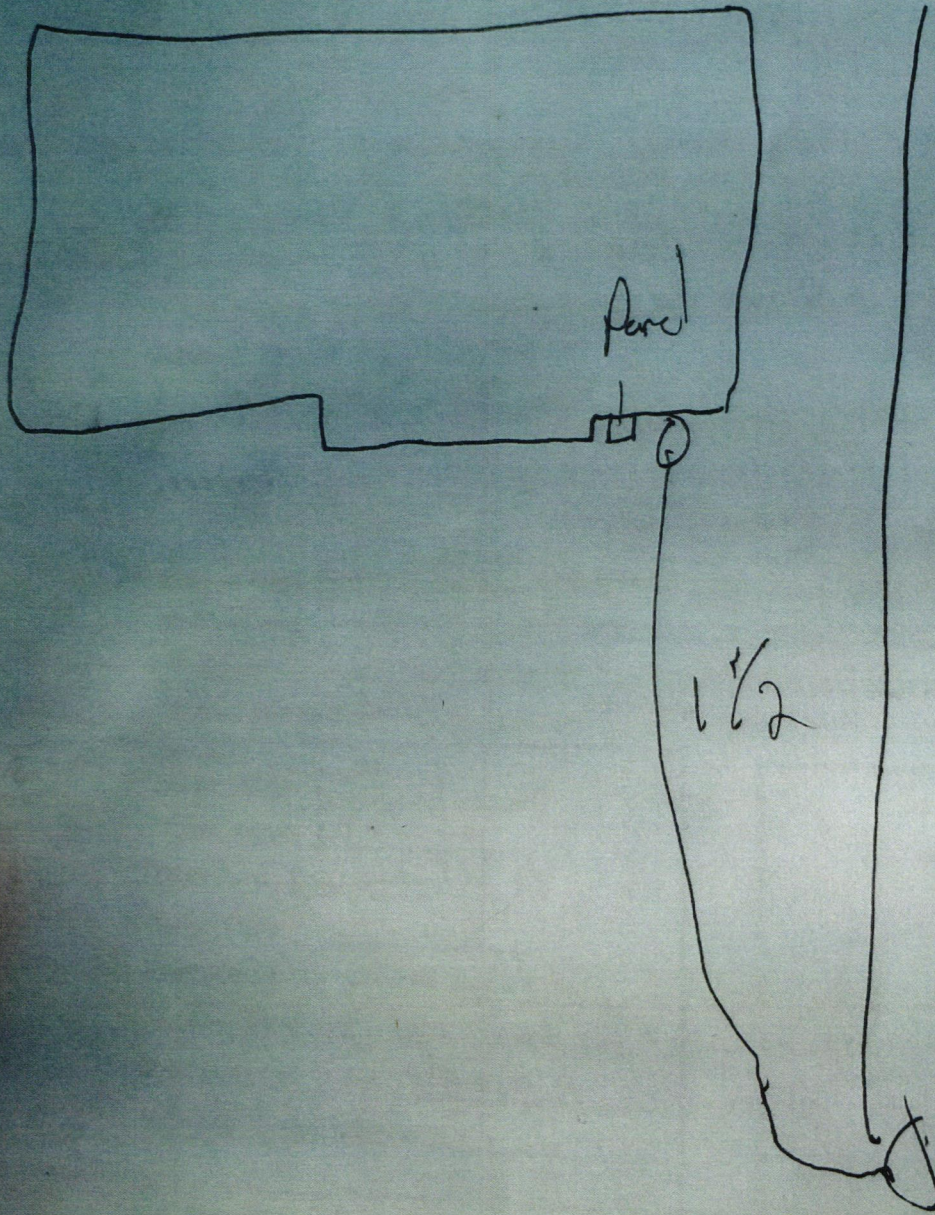

Property may not have been inspected when connection made in 2008. Drawing made June 2022.