



PROJECT Phase II

SHEET _____ OF _____


SUBJECT _____

DATE 1-18-18

JOB NO. 4447

BY Atlas

355 S. BROADWAY

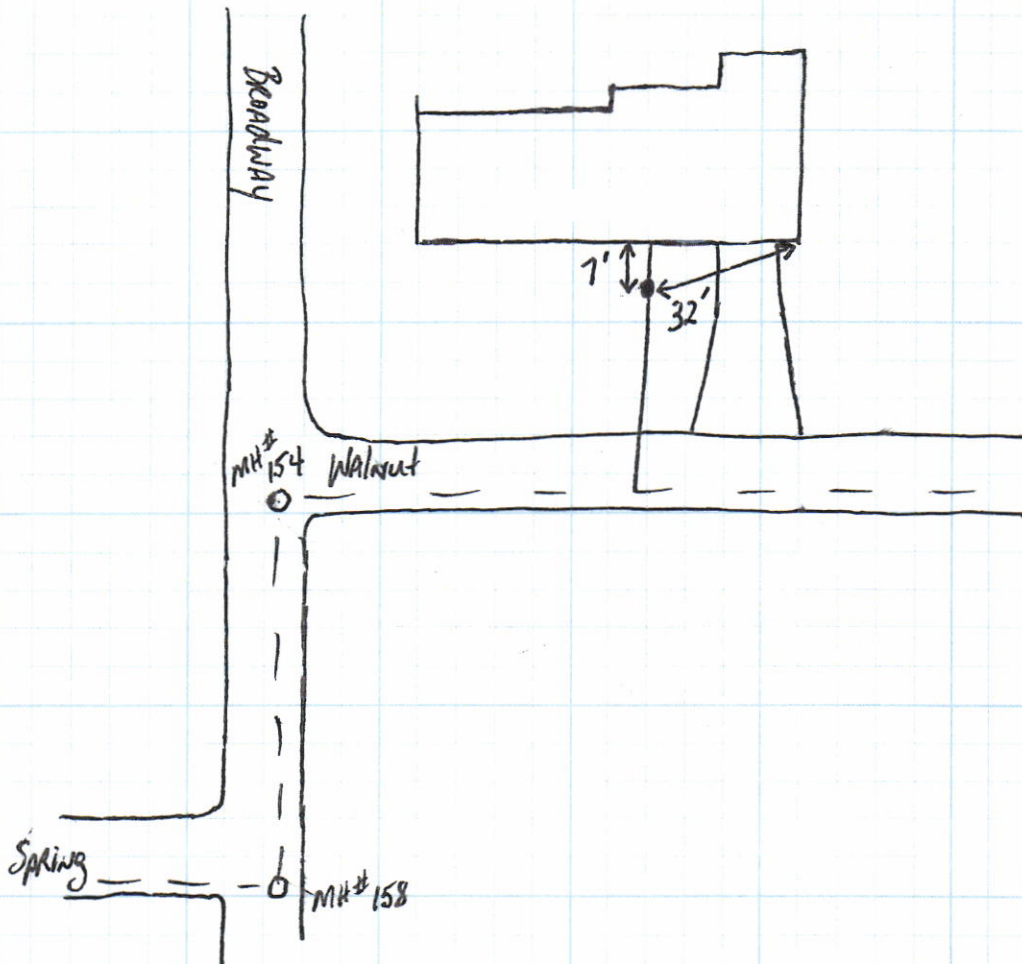

355 S Broadway

SRF Phase II

Jan 2018

