


Side

PROJECT Phase II SHEET _____ OF _____
SUBJECT _____ DATE 5-22-18
JOB NO. 4447
BY Atlas

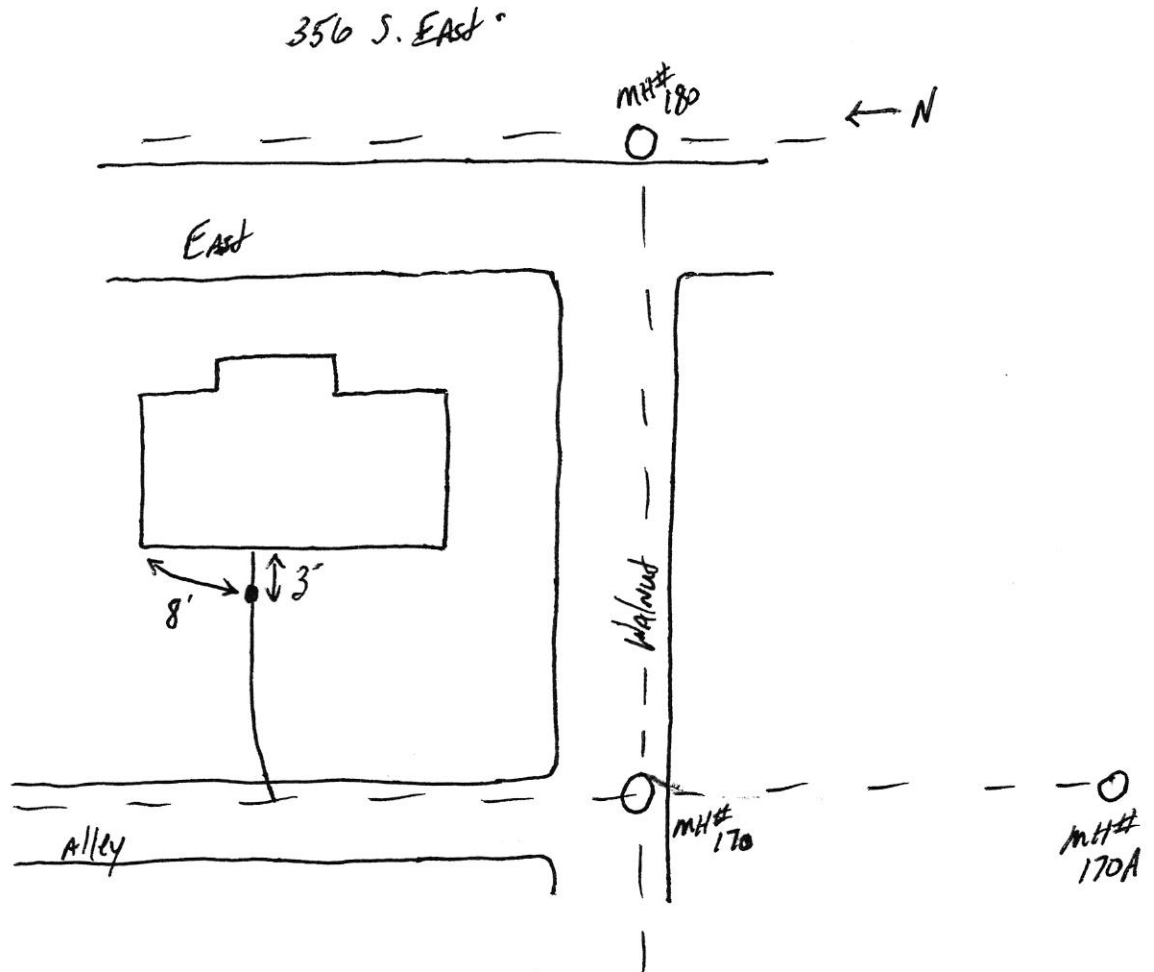

356 S East ST

SPE Phase II

5.25.18

