

Gidw.

PROJECT Phase II- SHEET _____ OF _____

SUBJECT _____ DATE 5-25-18


JOB NO. 4447

BY Atlas

356 S. Broadway

← N

Broadway

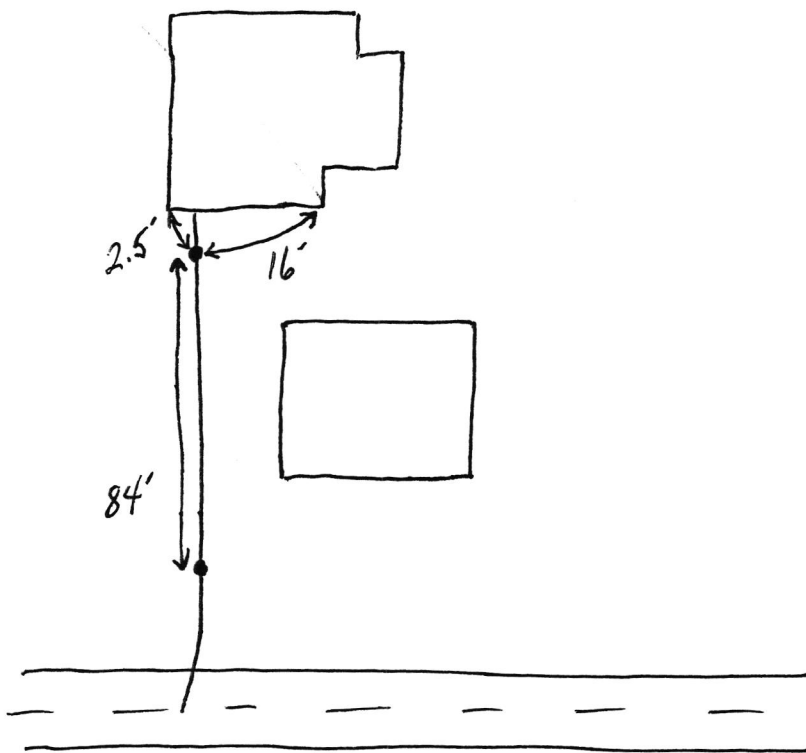



over S Broadway

SRT Phase II

S-25-18