

Gidw.

PROJECT Phase II- SHEET _____ OF _____

SUBJECT _____ DATE 5-25-18


JOB NO. 4447

BY Atlas

356 S. Broadway

← N

Broadway

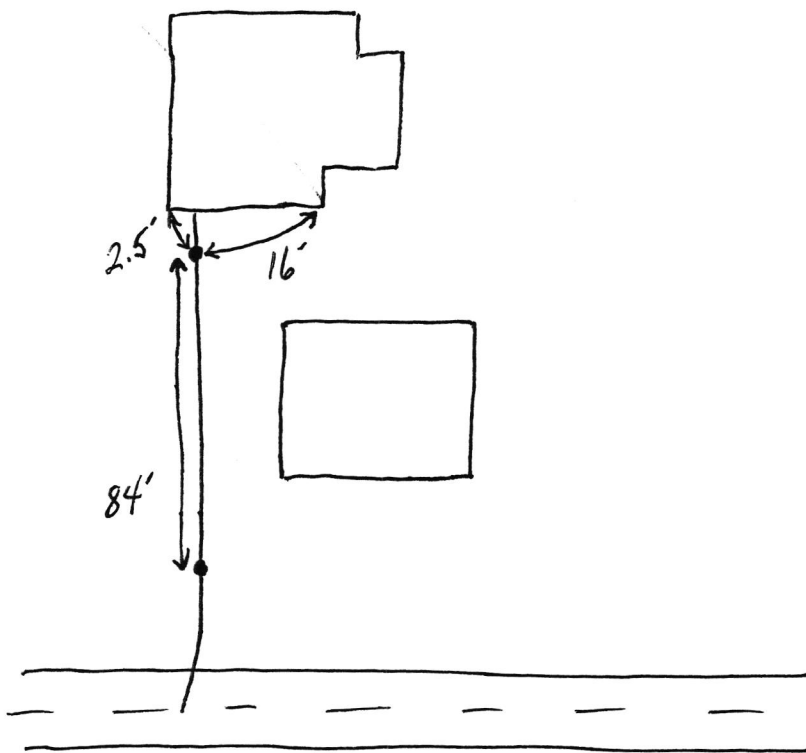

006 S Broadway

SRF Phase II

5-25-18



356 S Broadway
Fall Creek Plumbing

7/2/24

