


INDUSTRIAL GROUP

Carrick Glen
Lot 131 363 Limerick Ln.
9-1-23 with ex

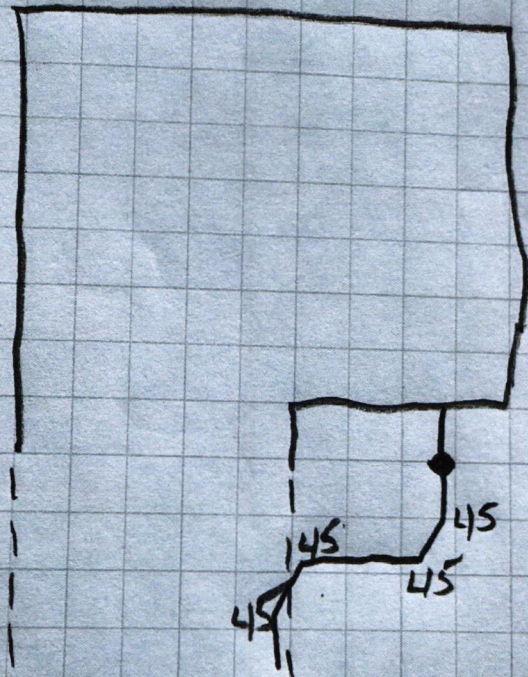

Indianapolis, IN
Fort Wayne, IN
Springfield, OH

Terre Haute, IN
Cincinnati, OH
Louisville, KY

hornerindustrial.com

1-877-467-6372

Your 24/7 source for Electric Motor Repair, New Motors, AC/DC Drives, Electro-Mechanical
Field Service. Custom Control and LED Lighting. Thermal Spray and Industrial Coatings,



THIS CHECK IS PRINTED IN RED AND BLUE INK ON THE FACE ON CHEMICAL AND BLEACH REACTIVE PAPER WITH INVISIBLE FLUORESCENT FIBERS AND BASKETWEAVE ON BACK MP

D.R. HORTON Since 1911
America's Builder

DRH Inc. Controlled Disb
1341 Horton Circle
Arlington, TX 76011

JP Morgan Chase Bank, N.A.
Syracuse, NY

Check Number 1457336

50-937

213

2720128

Date	Amount
02/21/22	\$*****760.00

Void after 6 months from date of issue

SEVEN HUNDRED SIXTY AND 00/100 *****

Pay To The Order Of:
FALL CREEK REGIONAL WASTE DISTRICT
9378 SOUTH 650 WEST
PENDLETON IN 46064

D. L. Horton

~~1457336~~ C6131

012099