

Gidw.

PROJECT Phase II SHEET _____ OF _____

SUBJECT _____ DATE 5-29-18


JOB NO. 4447

BY Atlas

400 S. Broadway

← N

Broadway

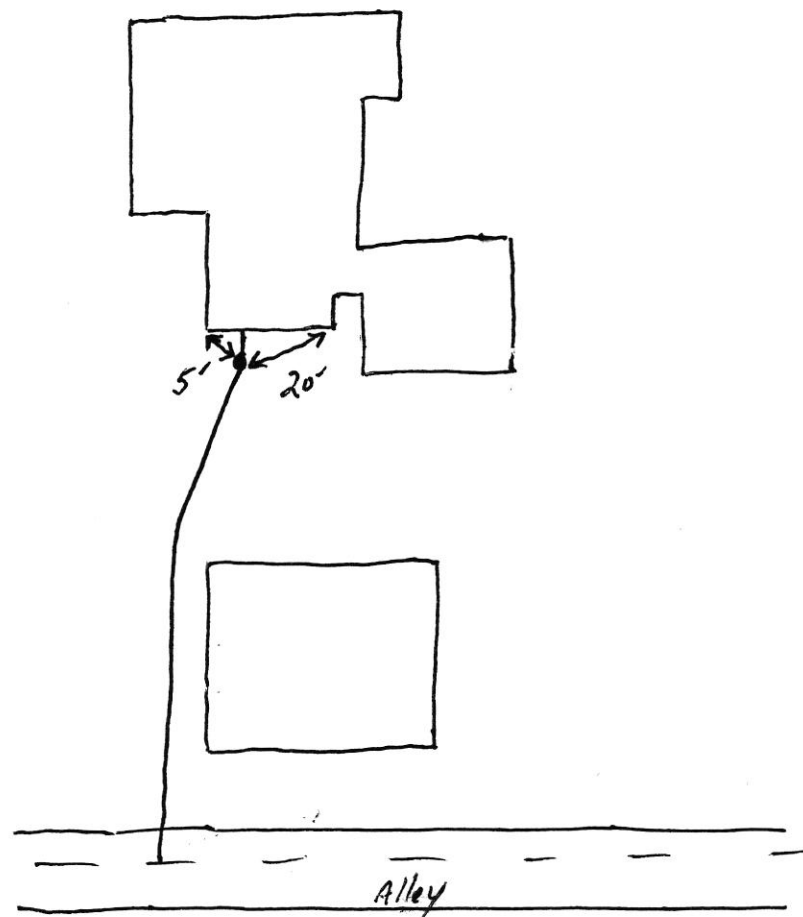

400 S Broadway

SRF Phase II

6.2.18

