

Gidw.



PROJECT Phase II SHEET _____ OF _____

SUBJECT _____ DATE 6-4-18

JOB NO. 4447

BY Atlas

400 W. State

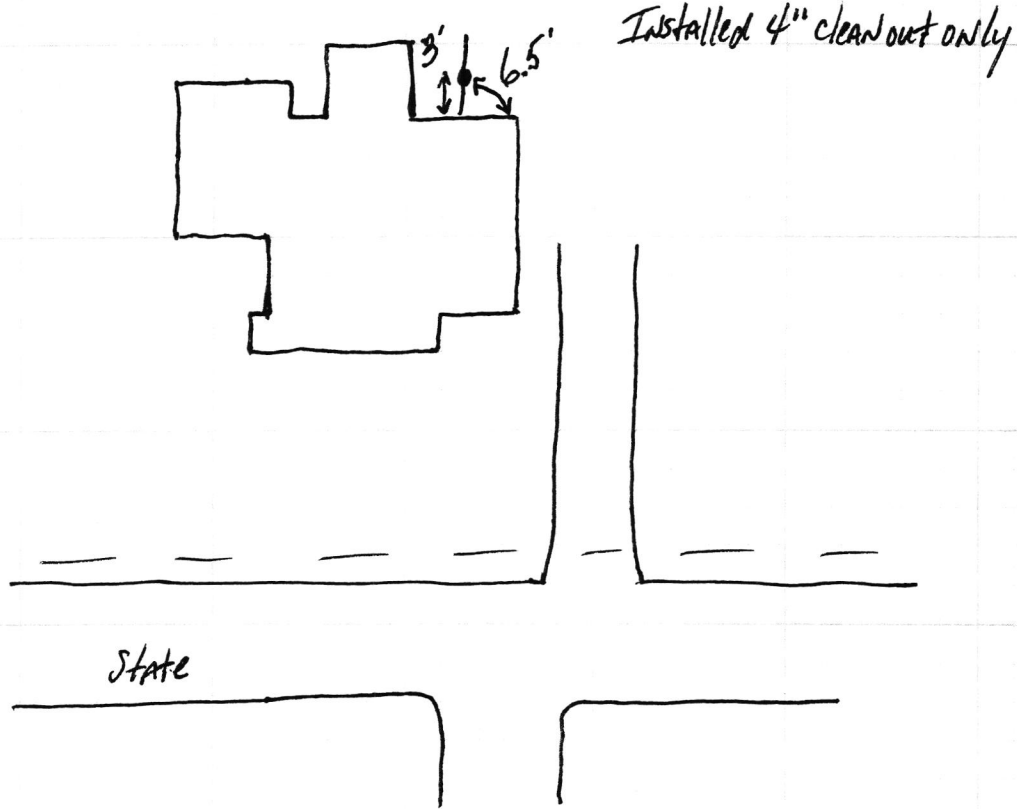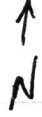

400 W State

SRF Phase II

4.11.18

