


Gidw.

PROJECT Phase II SHEET _____ OF _____
SUBJECT _____ DATE 6-6-18
JOB NO. 4447
BY Atlas

401 E. Madison

← N

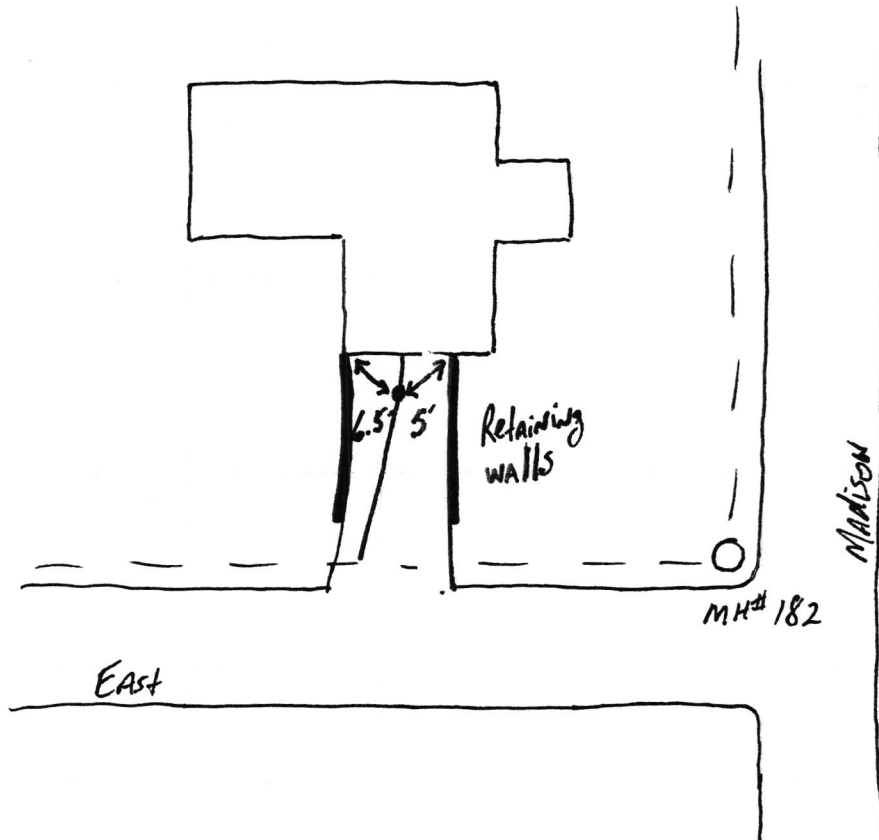

401 & Madison

SRE Phase II

6-11-18

