

Gidw.

PROJECT Phase II SHEET _____ OF _____

SUBJECT _____ DATE 6-14-88


JOB NO 4442

BY Atlas

401 S. East

← N

← lateral to 417 Madison

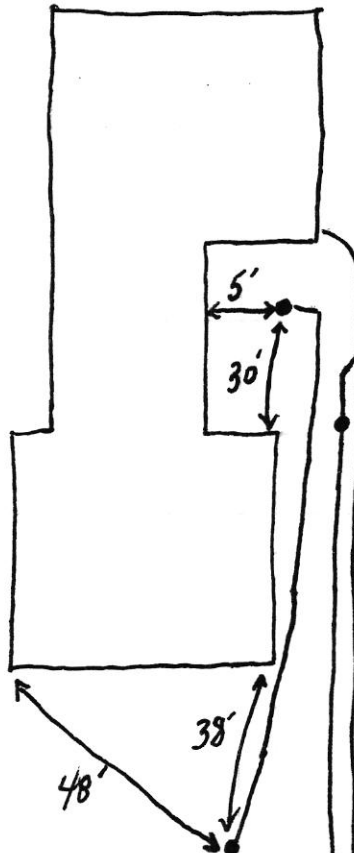

We never really figured out how the lateral ran out the house - it appeared to flow to the east then somehow made a U-turn west

Replaced 46" manhole to clean out

401 East St

SRF Phase II

6.19.18



401 East ST

SRP Phase II

6.19.18

