


Gidw.

PROJECT Phase II SHEET _____ OF _____
SUBJECT _____ DATE 3-6-18
JOB NO 4447
BY Atlas

401 Franklin

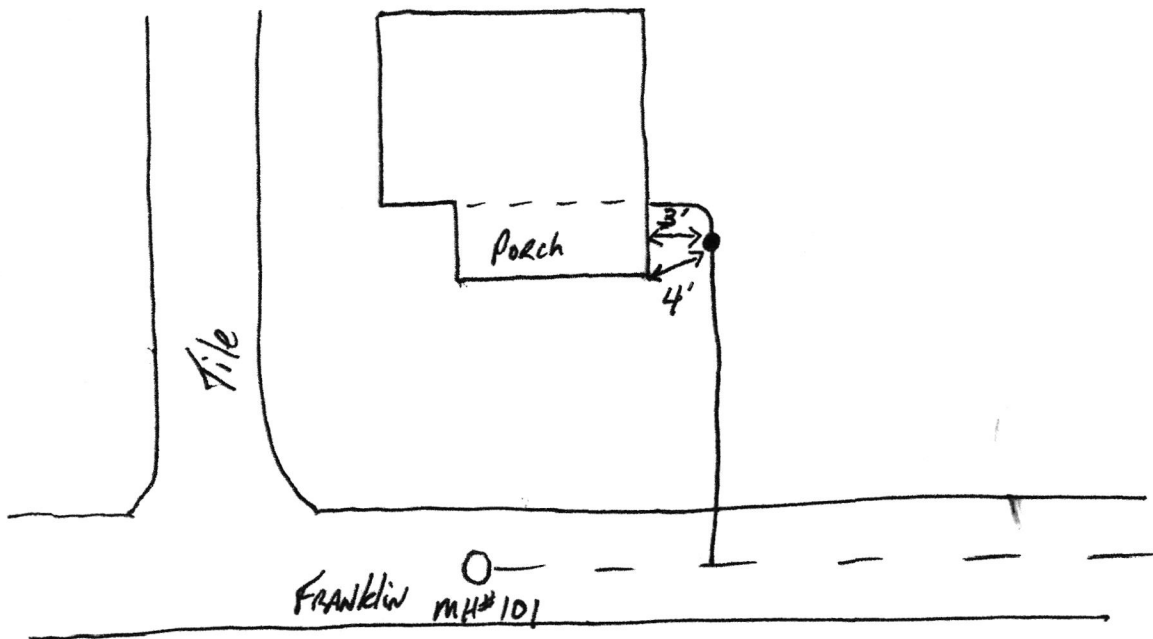

401 Franklin

SRP Phase II

