


Side

PROJECT Phase II SHEET _____ OF _____

SUBJECT _____ DATE 1-23-18

JOB NO. 4447

BY Atlas

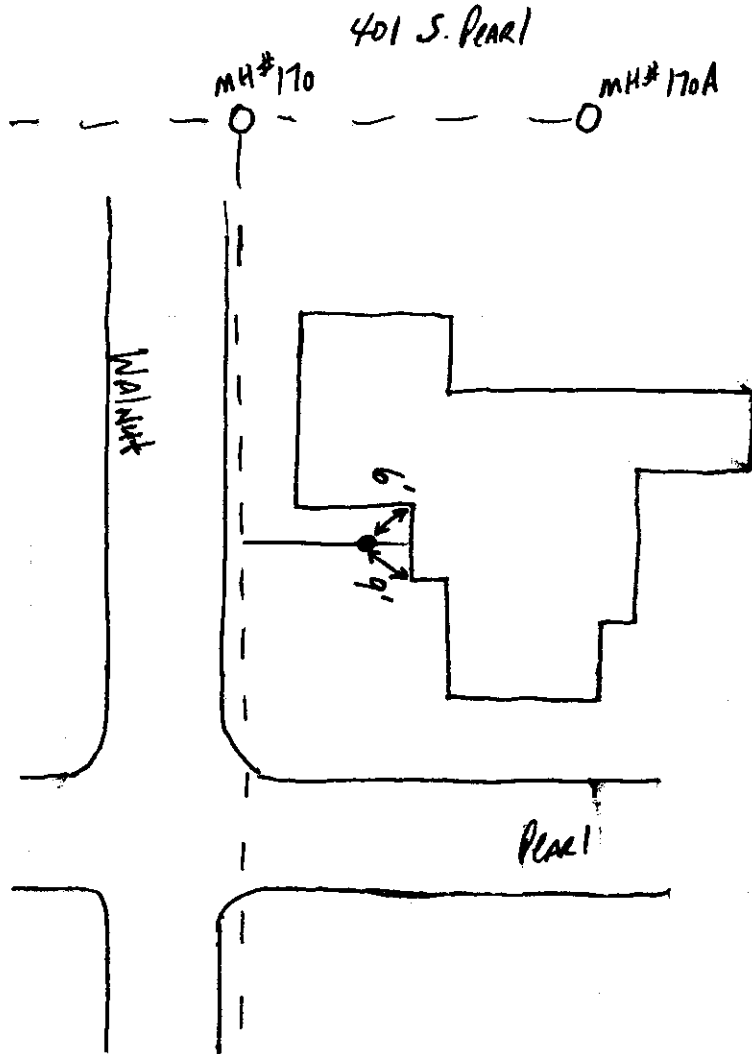

401 S Pearl

SRC Phase II

1.23.18

