

Gidw.

PROJECT

Phase II

SHEET

OF

SUBJECT

DATE

1-17-18


JOB NO

4447

BY

Atlas

401 S. BROADWAY

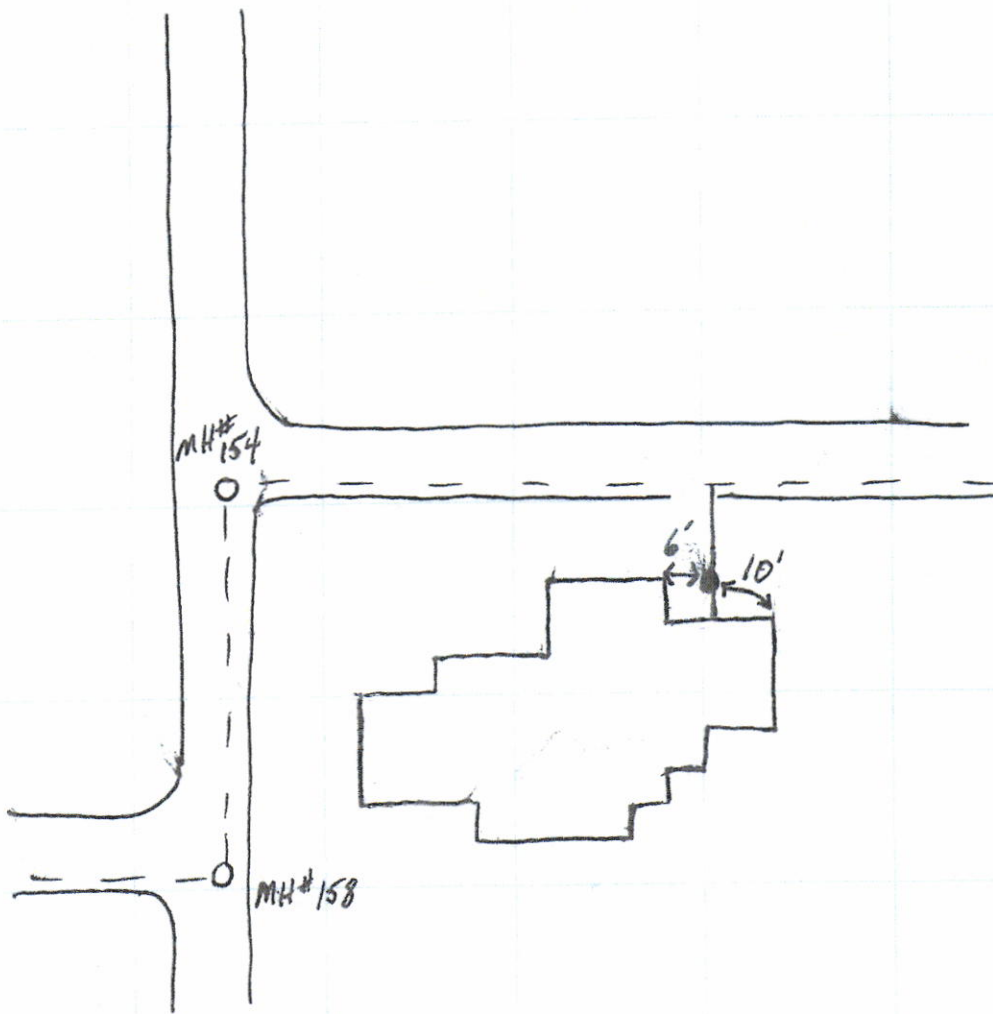

401 S Broadway

SRP Phase II

Jan 2018

