

Gidw.

PROJECT

Phase II

SHEET OF

SUBJECT


DATE 5-24-18

JOB NO 4447

BY Atlas

401 S. Pendleton

N →

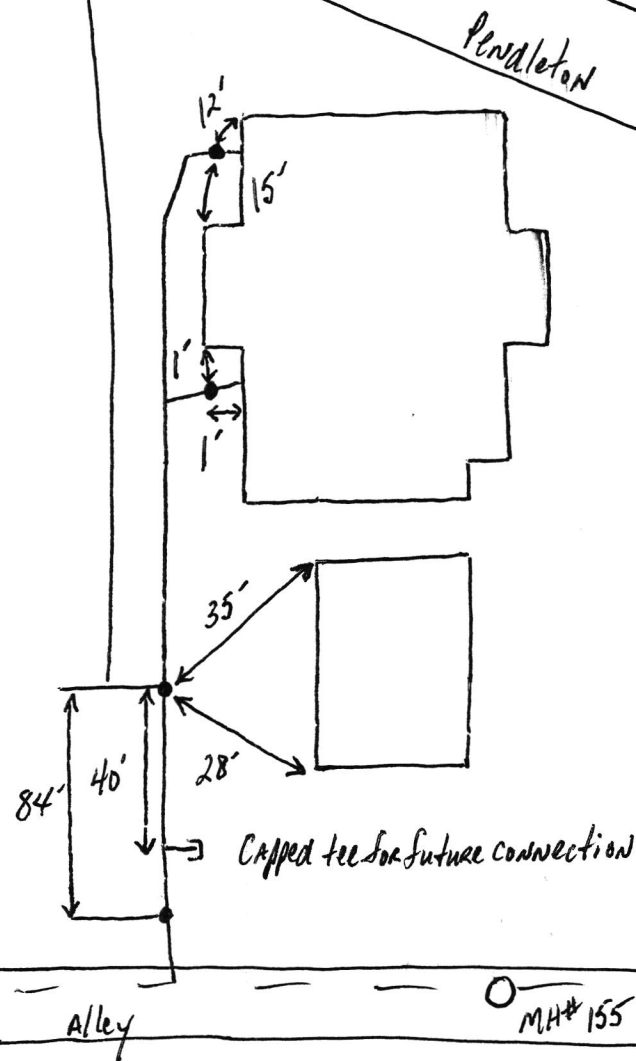



401 S Pendulutan

SRT Phase II

5.25.18





401 S Pendleton

SF Phase II

5.25.18





461 S Pendulutan

SRF Phase II

5.35.18

