


Gidw.

PROJECT Phase II SHEET _____ OF _____
SUBJECT _____ DATE 2-13-18
JOB NO. 4447
BY ALB

401 W. Taylor

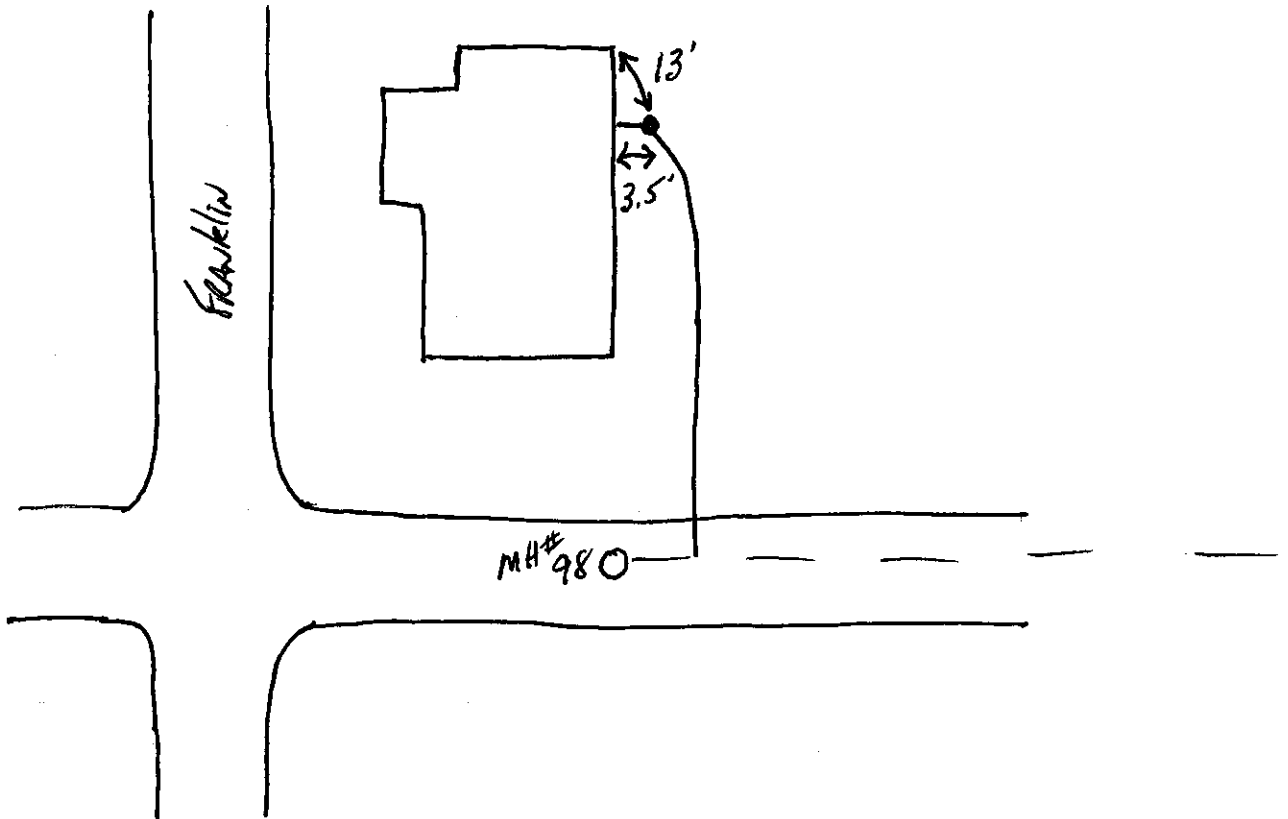

401 W Taylor

SRP Phase II

2.13.18

