


Gidw.

PROJECT Phase II SHEET _____ OF _____

SUBJECT _____ DATE 1-17-18

JOB NO. 4447

BY Atlas

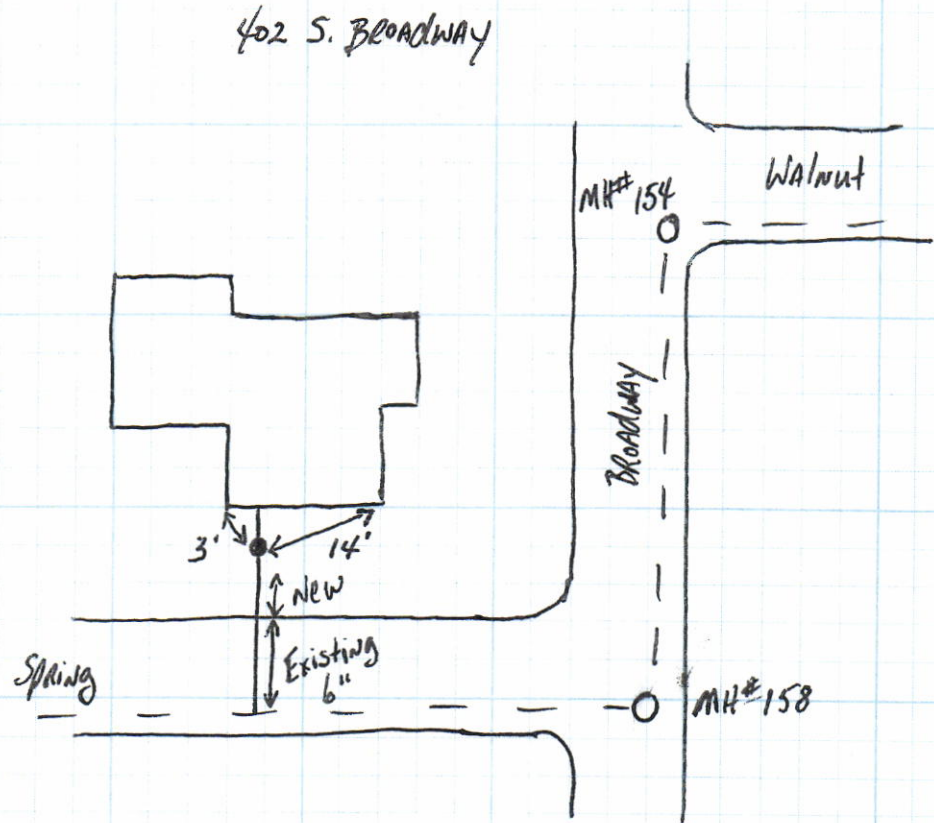

402 S Broadway

SRF Phase II

Jan 2018

