


Gidw.

PROJECT Phase II SHEET _____ OF _____
SUBJECT _____ DATE 1-22-18
JOB NO. 4447
BY Atlas

404 ~~E. Walnut~~ Pearl

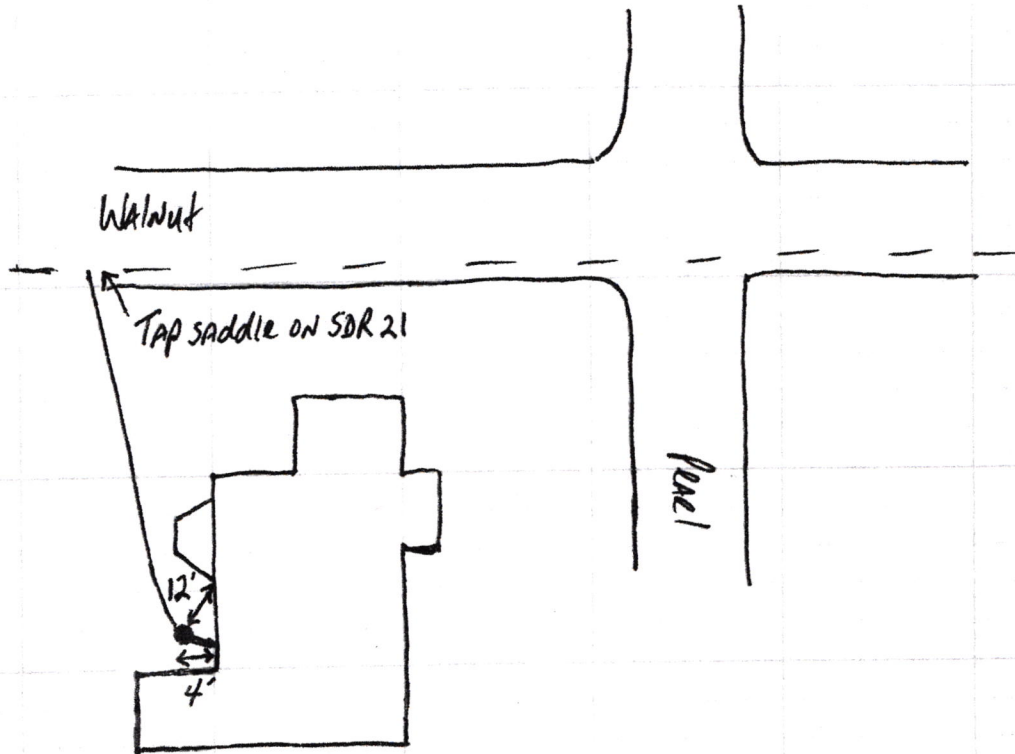

404 ~~& Walnut St~~
Pearl

SHF Phase II

Jan 2018

