


Gidw.

PROJECT Phase II SHEET _____ OF _____
SUBJECT _____ DATE 6-8-18
JOB NO 4447
BY Atlas

405 S. East

← N

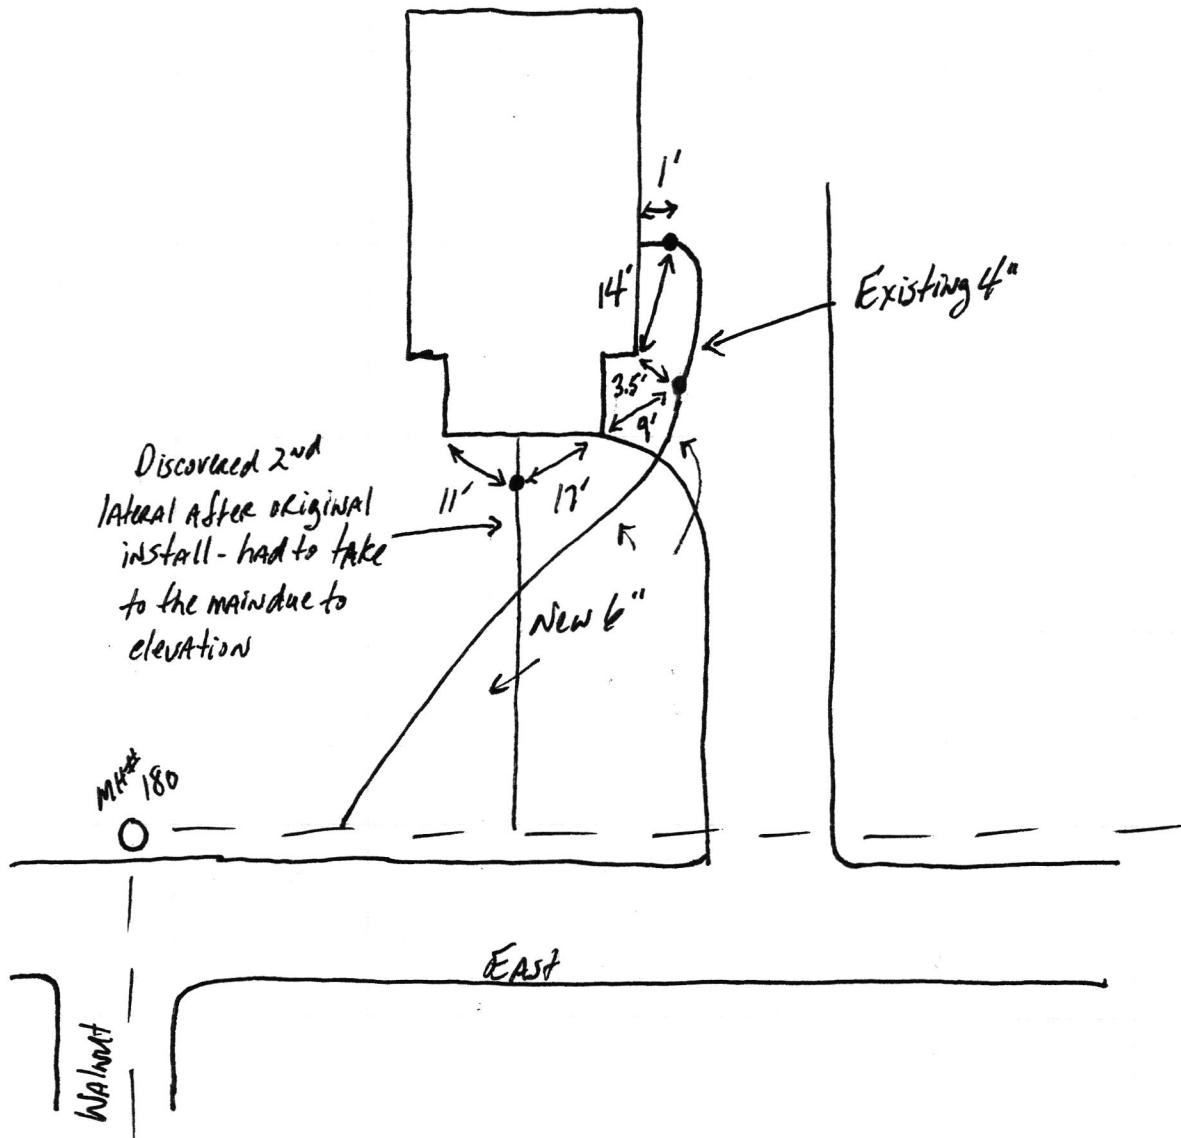

405 East St

SRF Phase II

6.19.18



405 S East

SRP Phase II

6.11.18



405 S East

SAP Phase II

6-11-18

