



FALL CREEK REGIONAL WASTE DISTRICT

Box 44, Pendleton, Indiana 46064

1-000 2305.00

Nº 000179

APPLICATION FOR SEWER PERMIT

Permit No. \_\_\_\_\_ Date 9-16-85  
Permit Void 90 days from Date of Issuance  
Owner Name EVERETT GUINN  
Property Address 405 N. ALFONTE  
Lot # \_\_\_\_\_ P.O. Box \_\_\_\_\_  
Town Ingalls, IN Zip Code 46048  
Phone \_\_\_\_\_ Water Meter Will be in Ing.  
\$ 150.00 Tap on Fee Paid  
\$ 25.00 Inspection fee paid

Application is hereby made for connection to the Fall Creek Regional Waste District Sewer System for the above listed property - Permit Type: Residential ☒, Commercial \_\_\_\_\_, Industrial \_\_\_\_\_, or Governmental/Institutional \_\_\_\_\_. User Information \_\_\_\_\_.

All workmanship and materials shall conform to the standards of the District Ordinance as described in Ordinance 84-2 and 84-3 as amended. Acceptance and approval must be made by the District inspector or his duly authorized representative before backfilling and final connection is made to the main sewer lines. Any violation of applicable regulations will cause all lines and appurtenances in violation to be removed and replaced at the owners expense.

The Fall Creek Regional Waste District is responsible for the inspection, approval of materials, and installation techniques only. All costs for materials and installation and any liabilities resulting from same is the sole responsibility of the property owner.

I have read and fully understand the above provisions and agree to comply by said provisions.

Everett Guinn

APPLICANT(S) SIGNATURE

INSPECTOR Roy

Date inspected 11-13-85 Approved ☒ Rejected \_\_\_\_\_

Reason for rejection \_\_\_\_\_

Date reinspected \_\_\_\_\_ Approved \_\_\_\_\_ Rejected \_\_\_\_\_

Notes:

Size Pipe 6"

Type Pipe PVC

Basement Yes \_\_\_\_\_ No \_\_\_\_\_

Sump Pump Yes \_\_\_\_\_ No \_\_\_\_\_


Downspout to Ground Yes \_\_\_\_\_ No \_\_\_\_\_

Septic Tank Pumped & filled Yes ☒ No \_\_\_\_\_

Contractor Kimerly

Special Conditions Not moving the trailer in till Monday

House Trailer Not At Sight yet.

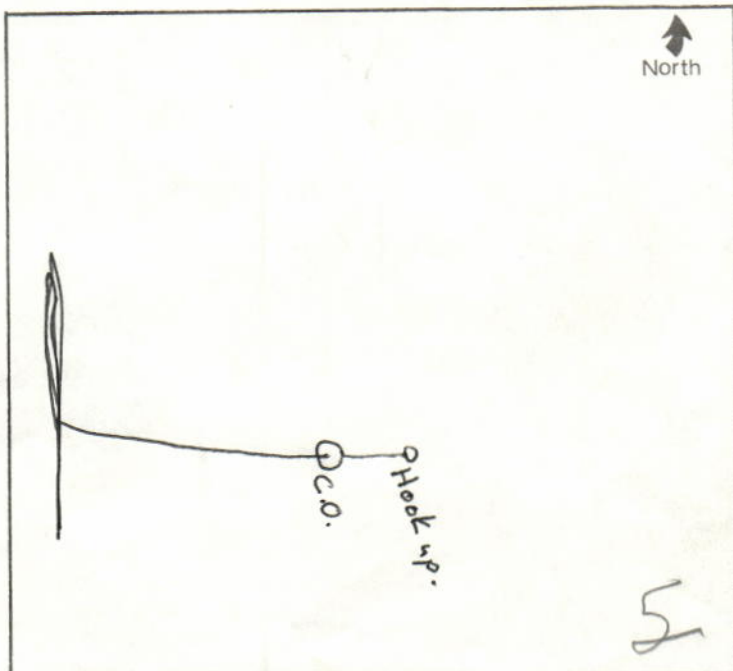





FALL CREEK REGIONAL WASTE DISTRICT

Box 44, Pendleton, Indiana 46064

on computer

310230501

APPLICATION FOR SEWER PERMIT

Nº 001829

Permit No. \_\_\_\_\_ Date 2/7/92  
Permit Void 90 days from Date of Issuance  
Owner Name Jose J. Martinez  
Property Address 1405 Almonte  
Lot # \_\_\_\_\_ P.O. Box 347  
Town Ingalls, IN Zip Code 46048-0347  
Phone \_\_\_\_\_ Water Meter \_\_\_\_\_"

\$ \_\_\_\_\_ Tap on Fee Paid

\$ \_\_\_\_\_ Inspection fee paid

reconnect 100.00  
2/7/92 paid 80.00  
Balance due 20.00

Application is hereby made for connection to the Fall Creek Regional Waste District Sewer System for the above listed property - Permit Type: Residential ☒, Commercial \_\_\_\_\_, Industrial \_\_\_\_\_, or Governmental/Institutional \_\_\_\_\_. User Information \_\_\_\_\_.

All workmanship and materials shall conform to the standards of the District Ordinance as described in Ordinance 84-2 and 84-3 as amended. Acceptance and approval must be made by the District inspector or his duly authorized representative before backfilling and final connection is made to the main sewer lines. Any violation of applicable regulations will cause all lines and appurtenances in violation to be removed and replaced at the owners expense.

The Fall Creek Regional Waste District is responsible for the inspection, approval of materials, and installation techniques only. All costs for materials and installation and any liabilities resulting from same is the sole responsibility of the property owner.

I have read and fully understand the above provisions and agree to comply by said provisions.

X Jose J. Martinez  
APPLICANT(S) SIGNATURE

\*\*\*\*\*

INSPECTOR B

Date inspected ? Approved \_\_\_\_\_ Rejected \_\_\_\_\_

Reason for rejection \_\_\_\_\_

Date reinspected \_\_\_\_\_ Approved \_\_\_\_\_ Rejected \_\_\_\_\_

Notes:

Size Pipe \_\_\_\_\_"

Type Pipe \_\_\_\_\_

Basement Yes \_\_\_\_\_ No \_\_\_\_\_

Sump Pump Yes \_\_\_\_\_ No \_\_\_\_\_

Downspout to Ground Yes \_\_\_\_\_ No \_\_\_\_\_

Septic Tank Pumped & filled Yes \_\_\_\_\_ No \_\_\_\_\_

Contractor \_\_\_\_\_

Special Conditions \_\_\_\_\_

Re connect only

