

Gidw.

PROJECT Phase II SHEET _____ OF _____


SUBJECT _____ DATE 5-24-18

JOB NO. 4447

BY Atlas

405 S. Pendleton

N →

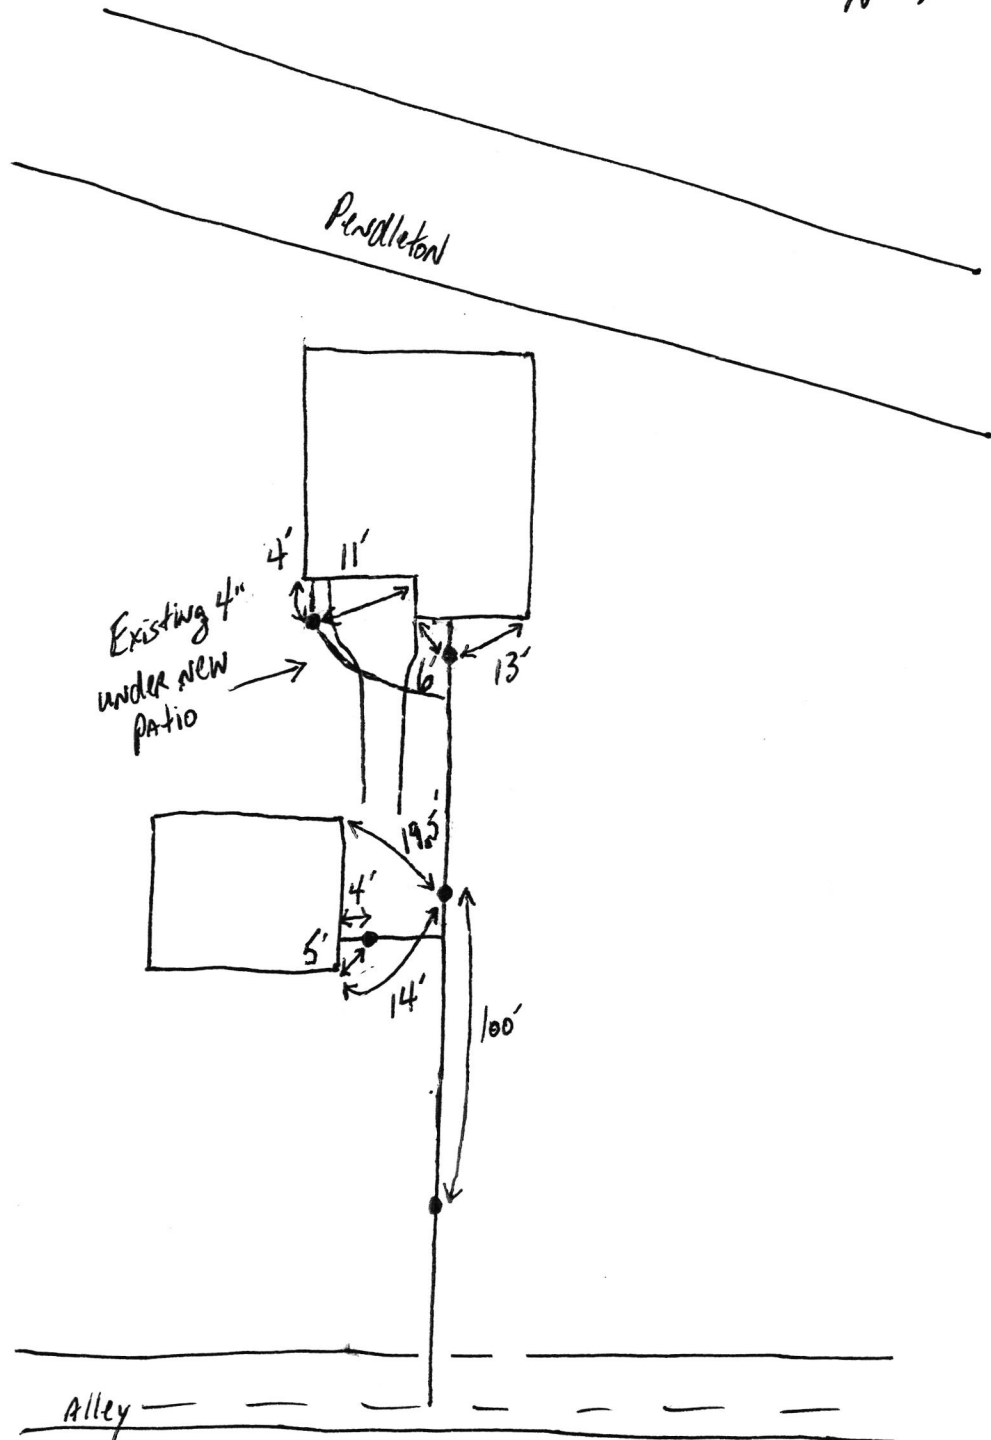

405 S Pendleton

SRF Phase II

5.25.18



465 s Pendulation

SRT Phase II

5.25.18



100 S. Hendrixton

S&P Phase II

5.25.18

