




PROJECT Phase II SHEET _____ OF _____

SUBJECT _____ DATE 6-5-18

JOB NO. 4447

BY Atlas

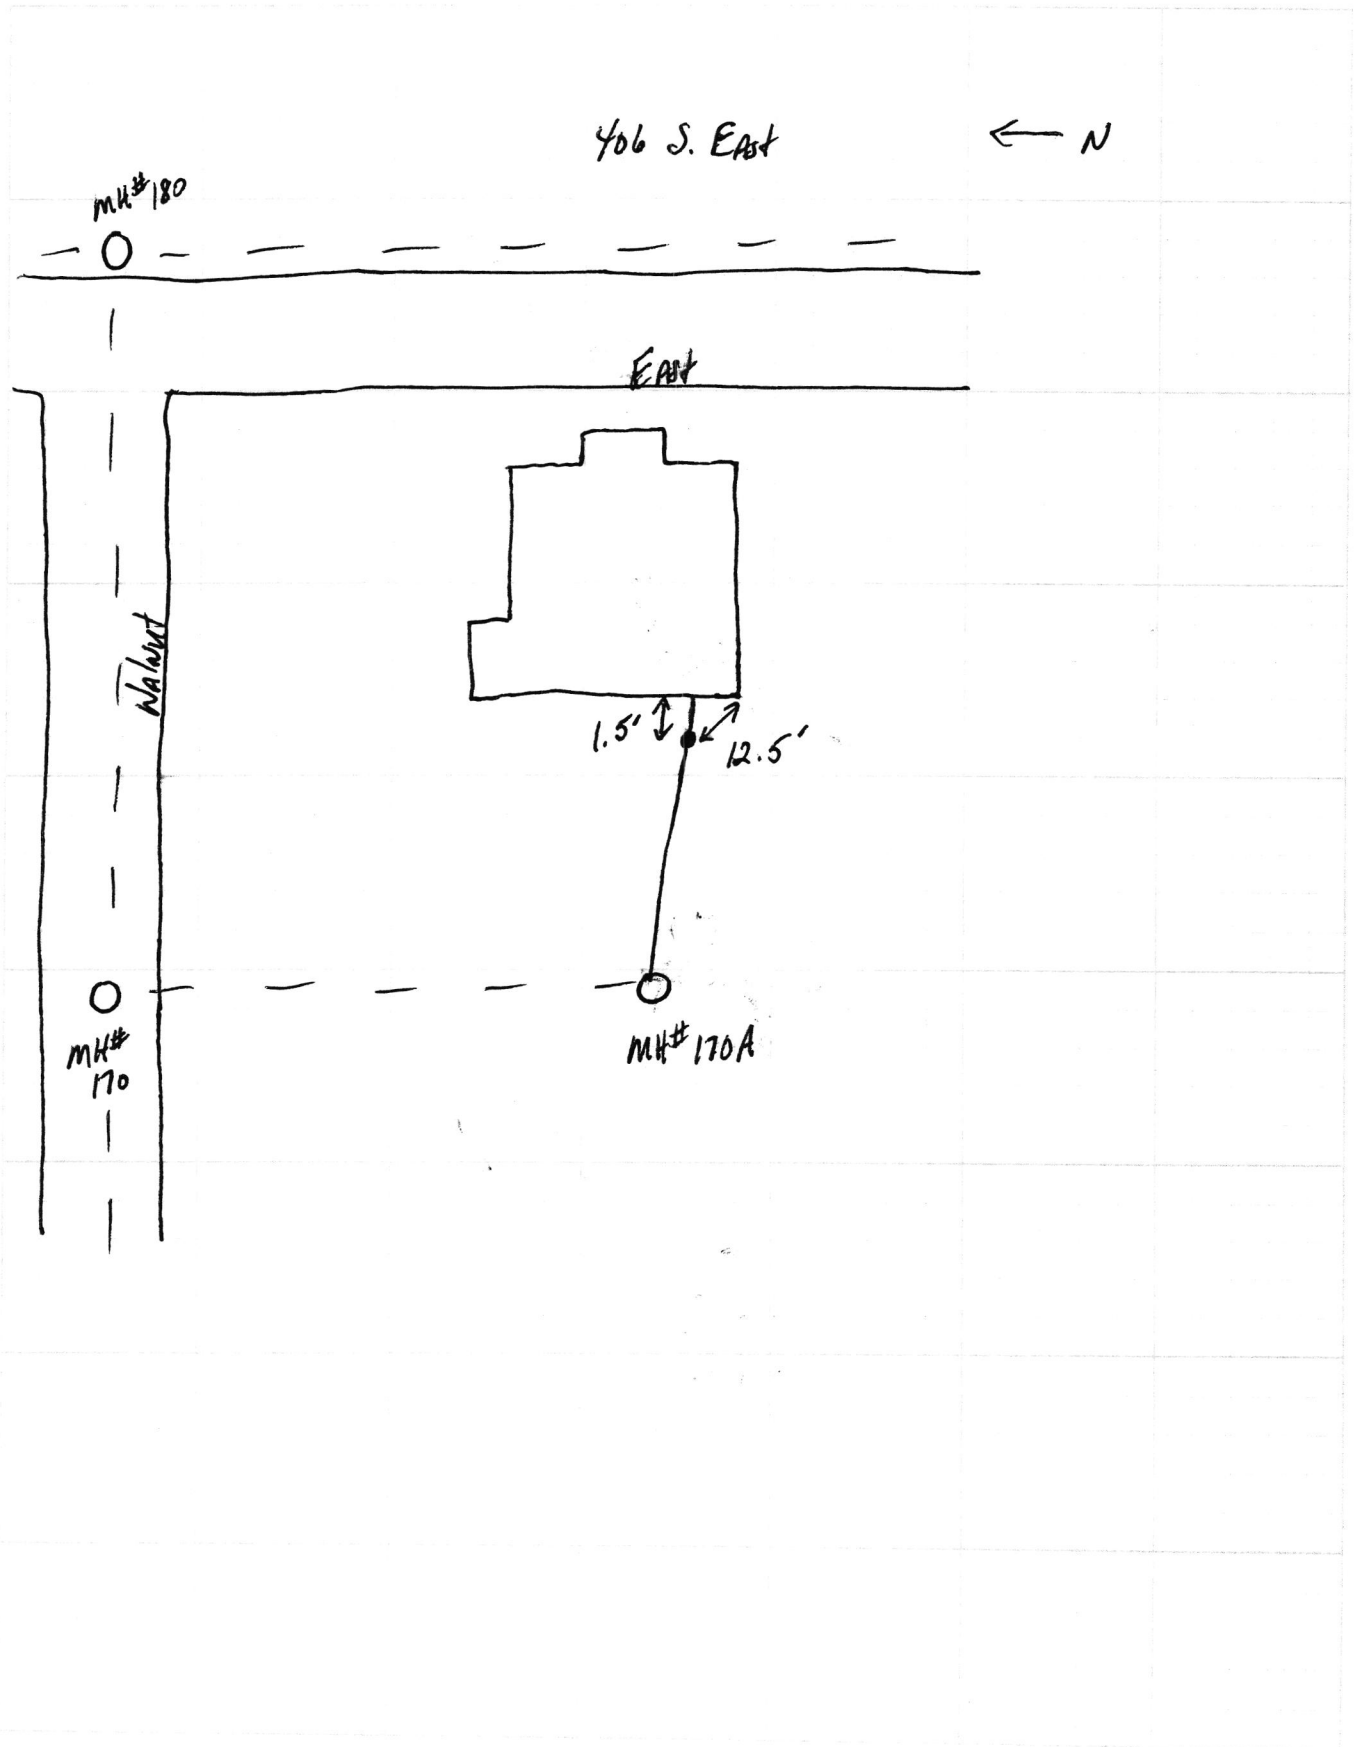

Hole S East

SRF Phase II

6.11.18

