

Gidw.


PROJECT Phase II SHEET _____ OF _____

SUBJECT _____ DATE 6-6-18

JOB NO. 4447

BY Atlas

407 E. Madison

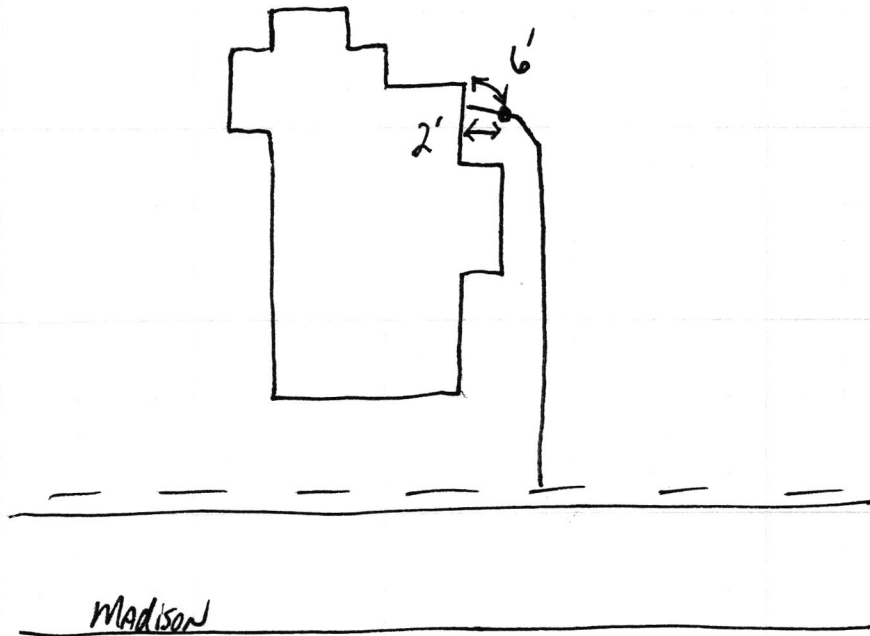

407 E Madison

SRF Phase II

6.11.18

