

Gidw.


PROJECT Phase II SHEET _____ OF _____

SUBJECT _____ DATE 4- -18

JOB NO. 4447

BY Atlas

407 W. State

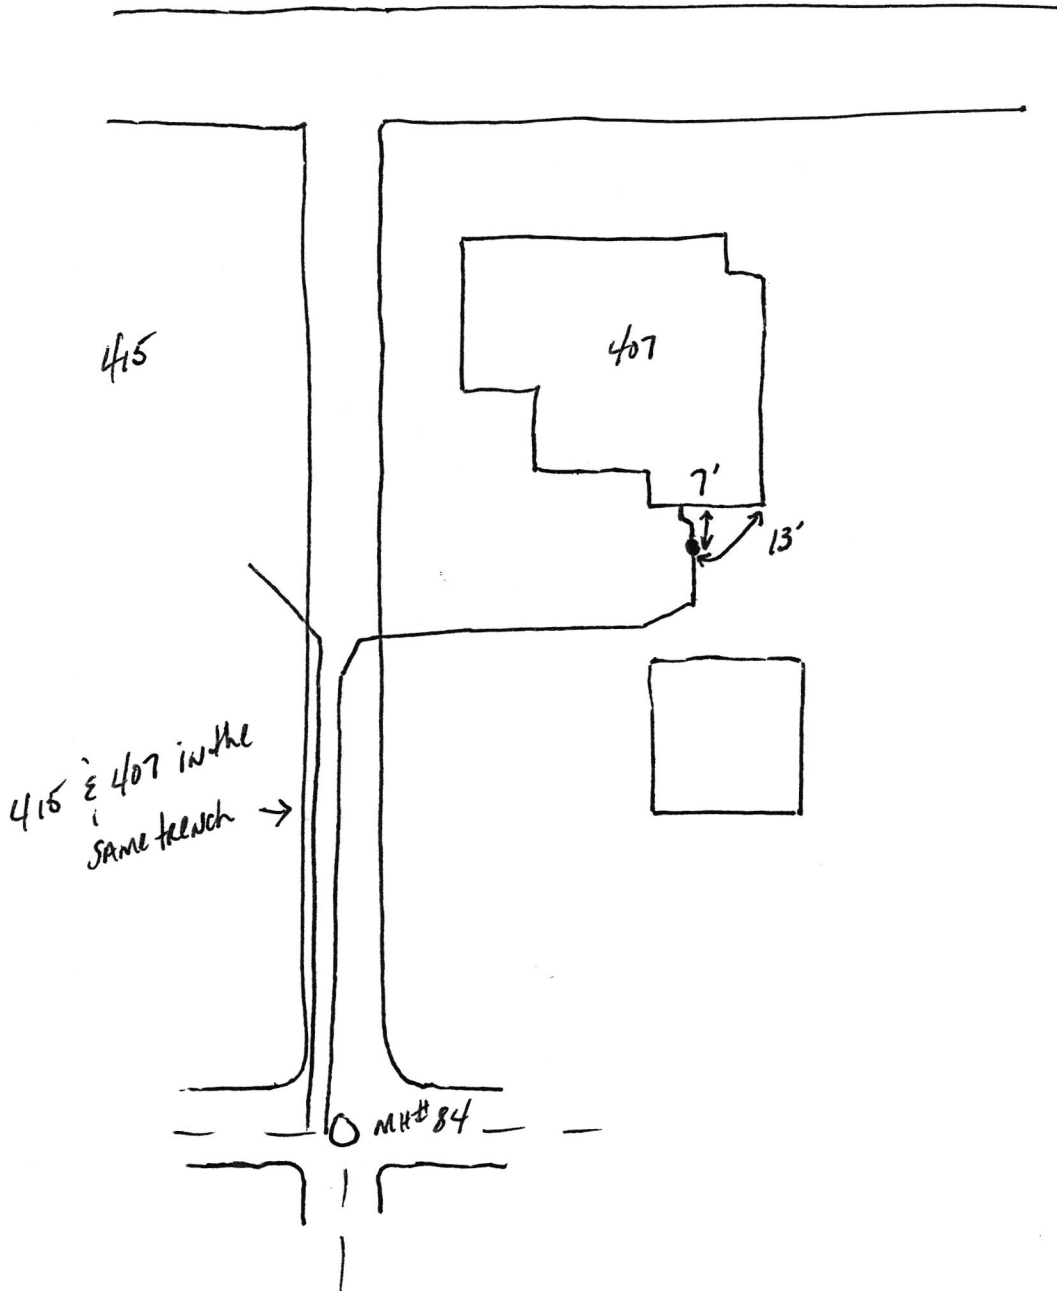

407 W State

SRP
Phase II

4.24.18

