


GISW.

PROJECT Phase II SHEET _____ OF _____

SUBJECT _____ DATE 3-14-18

JOB NO. 4447

BY Atlas

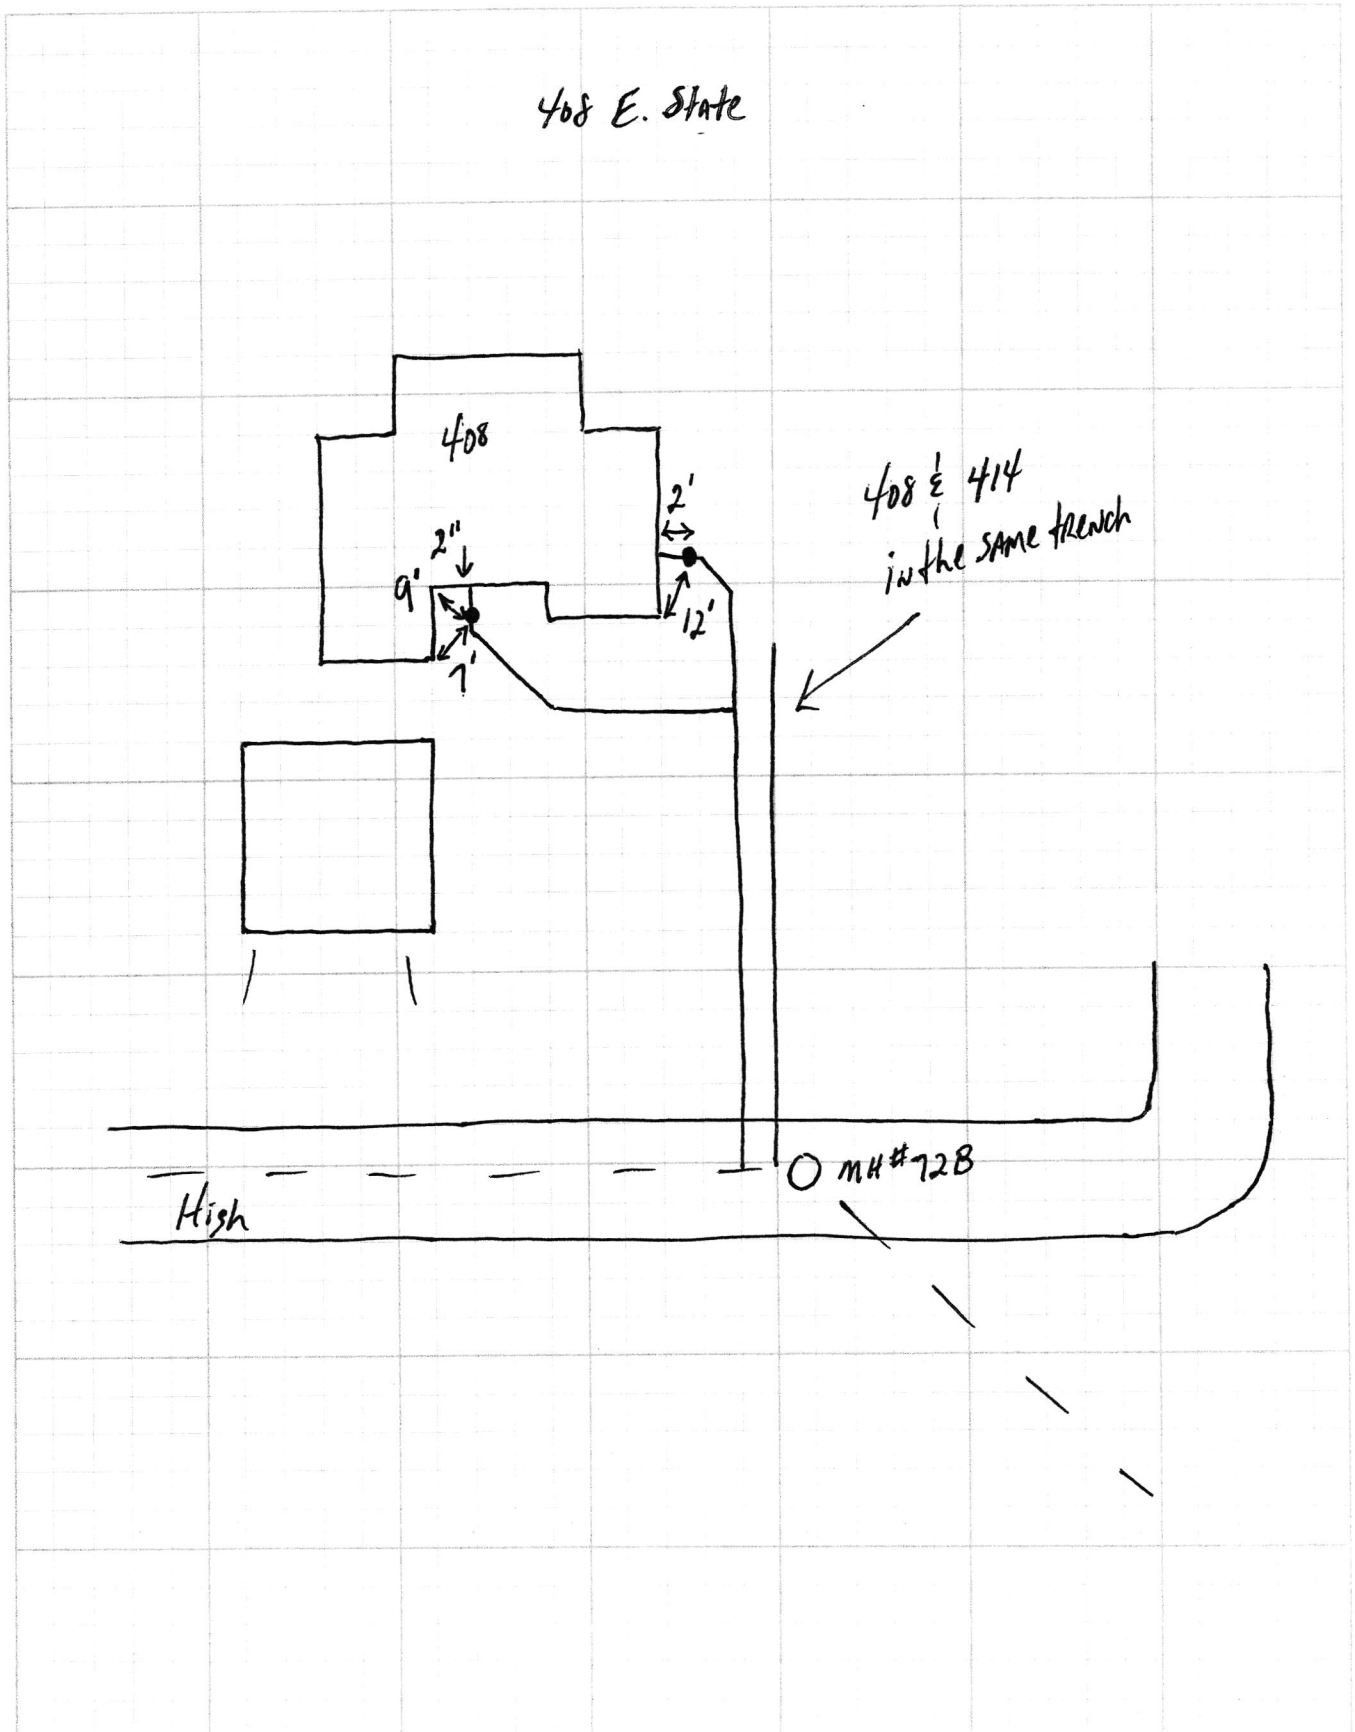

408 E State

SRP Phase II

