

Side

PROJECT Phase II SHEET _____ OF _____


SUBJECT _____ DATE 6-8-18

JOB NO. 4447

BY AT/AS

408 S. East

N →

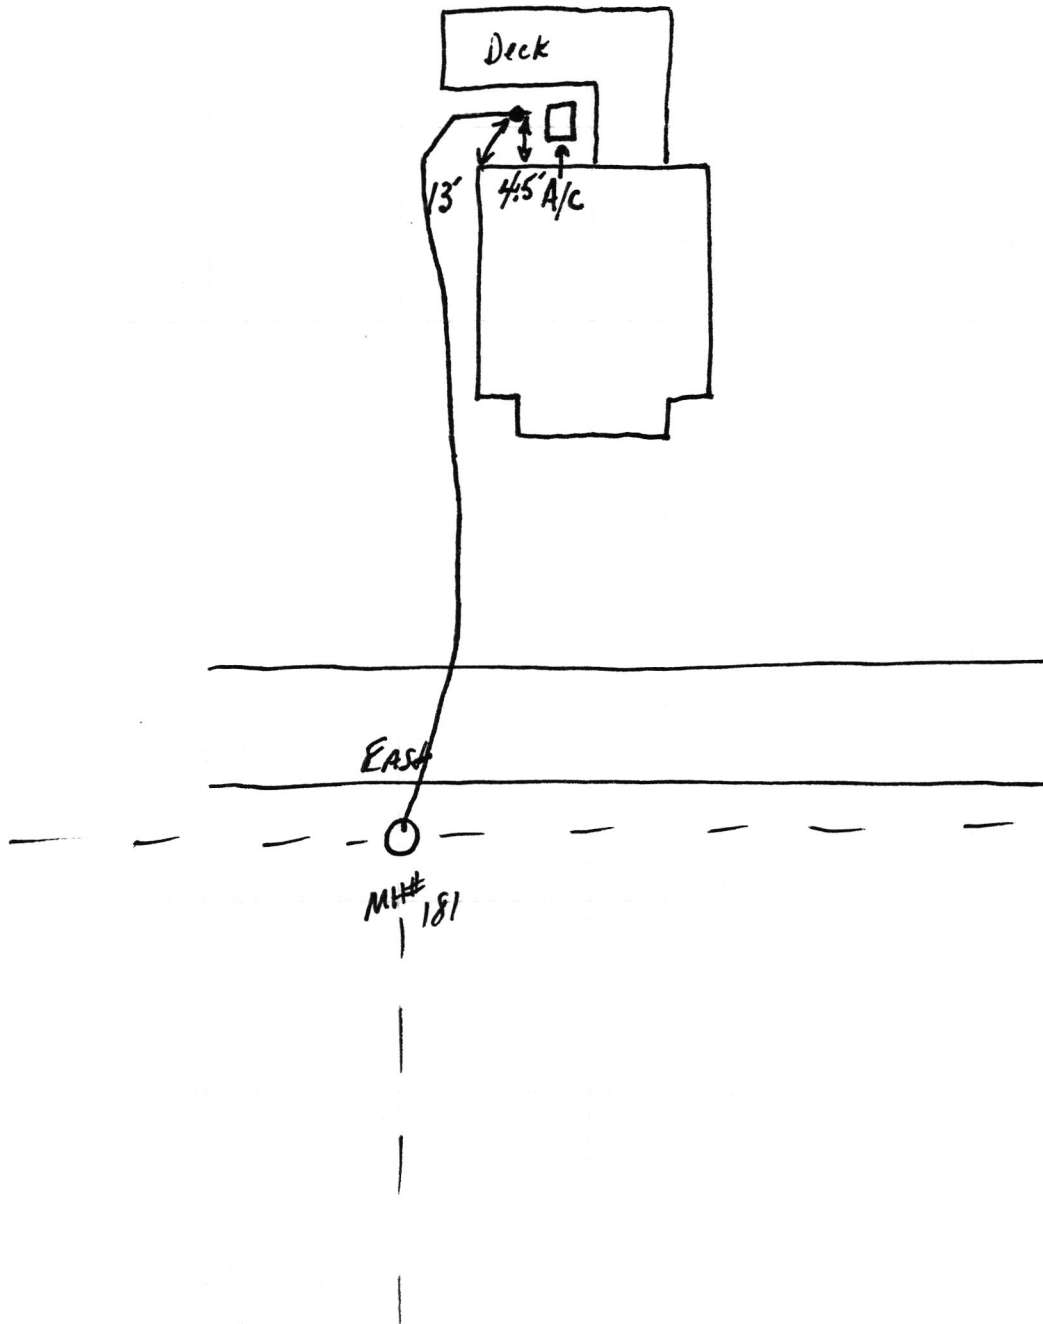



408 & East

SRC Phase II

Co. 11.18