



FALL CREEK REGIONAL WASTE DISTRICT

Box 44, Pendleton, Indiana 46064

add order on
file

on computer

210264700

Nº 001842

APPLICATION FOR SEWER PERMIT

Permit No. _____ Date 4/27/92

Permit Void 90 days from Date of Issuance

Owner Name Sherry WallaceProperty Address 408 N DuatonLot # 18+19 P.O. Box 355Town Engels, IN Zip Code 46048

Phone _____ Water Meter _____

\$ 700.00 Tap on Fee Paid\$ 25.00 Inspection fee paid

Application is hereby made for connection to the Fall Creek Regional Waste District Sewer System for the above listed property - Permit Type: Residential ☒, Commercial _____, Industrial _____, or Governmental/Institutional _____. User Information _____.

All workmanship and materials shall conform to the standards of the District Ordinance as described in Ordinance 84-2 and 84-3 as amended. Acceptance and approval must be made by the District inspector or his duly authorized representative before backfilling and final connection is made to the main sewer lines. Any violation of applicable regulations will cause all lines and appurtenances in violation to be removed and replaced at the owners expense.

The Fall Creek Regional Waste District is responsible for the inspection, approval of materials, and installation techniques only. All costs for materials and installation and any liabilities resulting from same is the sole responsibility of the property owner.

I have read and fully understand the above provisions and agree to comply by said provisions.


X Sherry A. Wallace
APPLICANT(S) SIGNATURE

INSPECTOR [Signature]Date inspected 5-4-92 Approved ☒ Rejected _____

Reason for rejection _____

Date reinspected _____ Approved _____ Rejected _____

Notes:

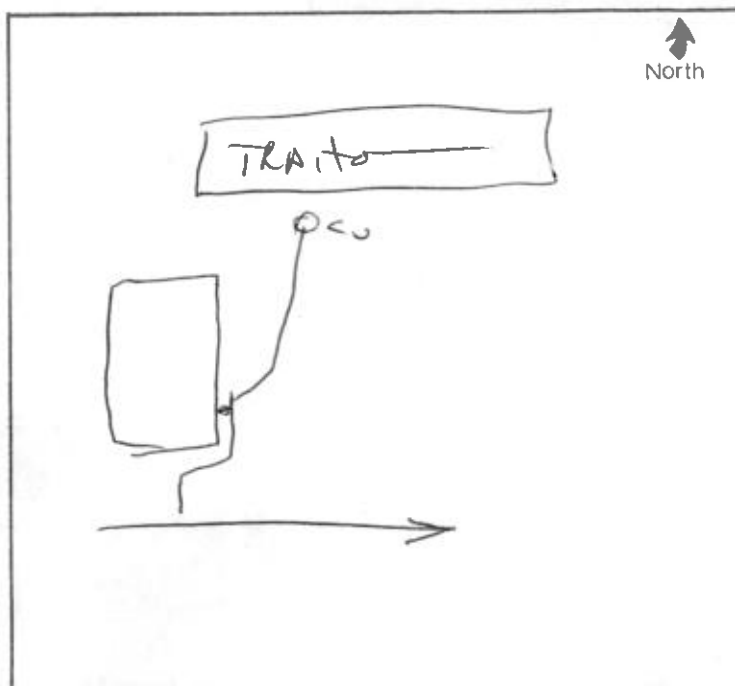Size Pipe 6 "Type Pipe PVCBasement Yes _____ No ☒Sump Pump Yes _____ No ☒Downspout to Ground Yes ☒ No _____Septic Tank Pumped & filled Yes _____ No ☒Contractor Wilson CommSpecial Conditions MW Comm



FALL CREEK REGIONAL WASTE DISTRICT

Box 11, P.O. Station, Jackson, Idaho 83201

Invoice No.

IN 001845

4/27/92

Shirley W. Johnson
HOS N. Jackson

325
46048

18419

Shirley W. Johnson

100.00


82.00

X

Shirley W. Johnson

325

2-11-92

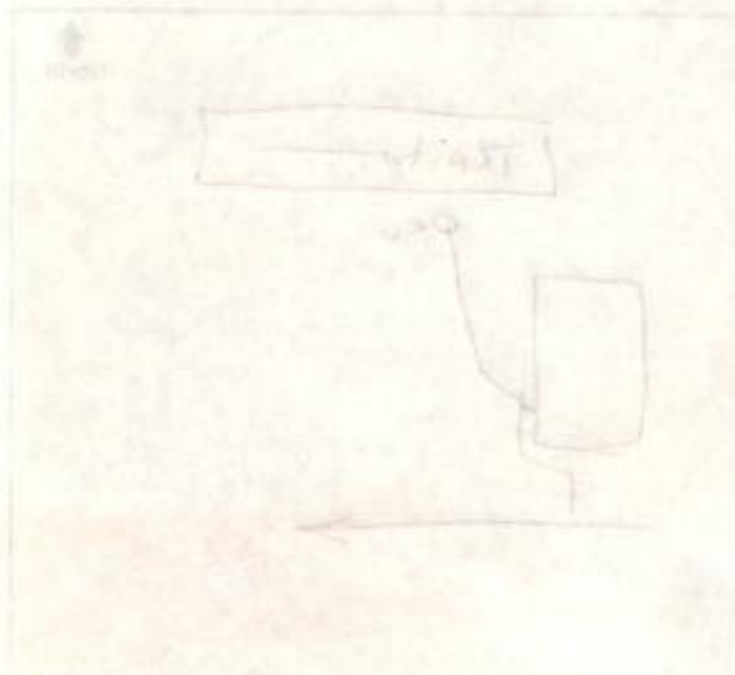

Shirley W. Johnson
HOS N. Jackson
325
46048
18419
Shirley W. Johnson
100.00
82.00
X