
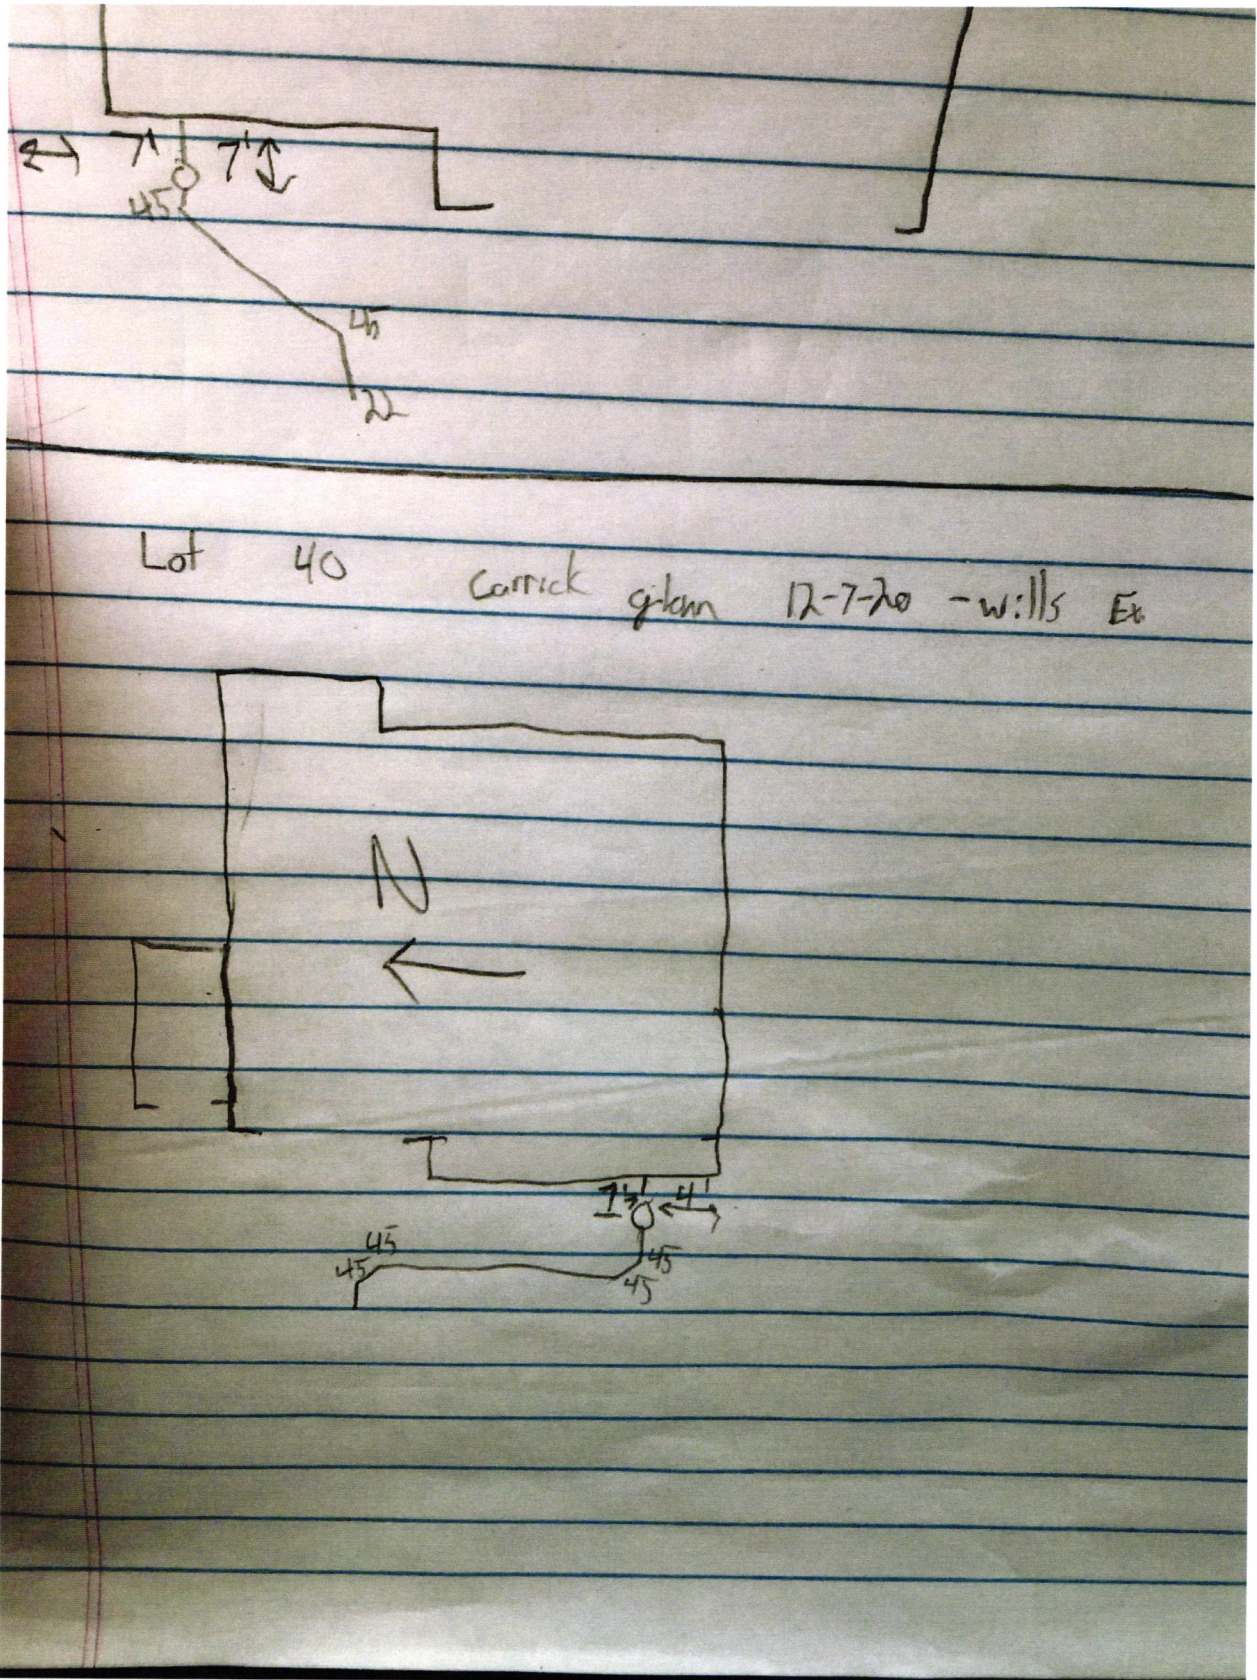



#6706

North 

Drawing
+
2 pictures
attached





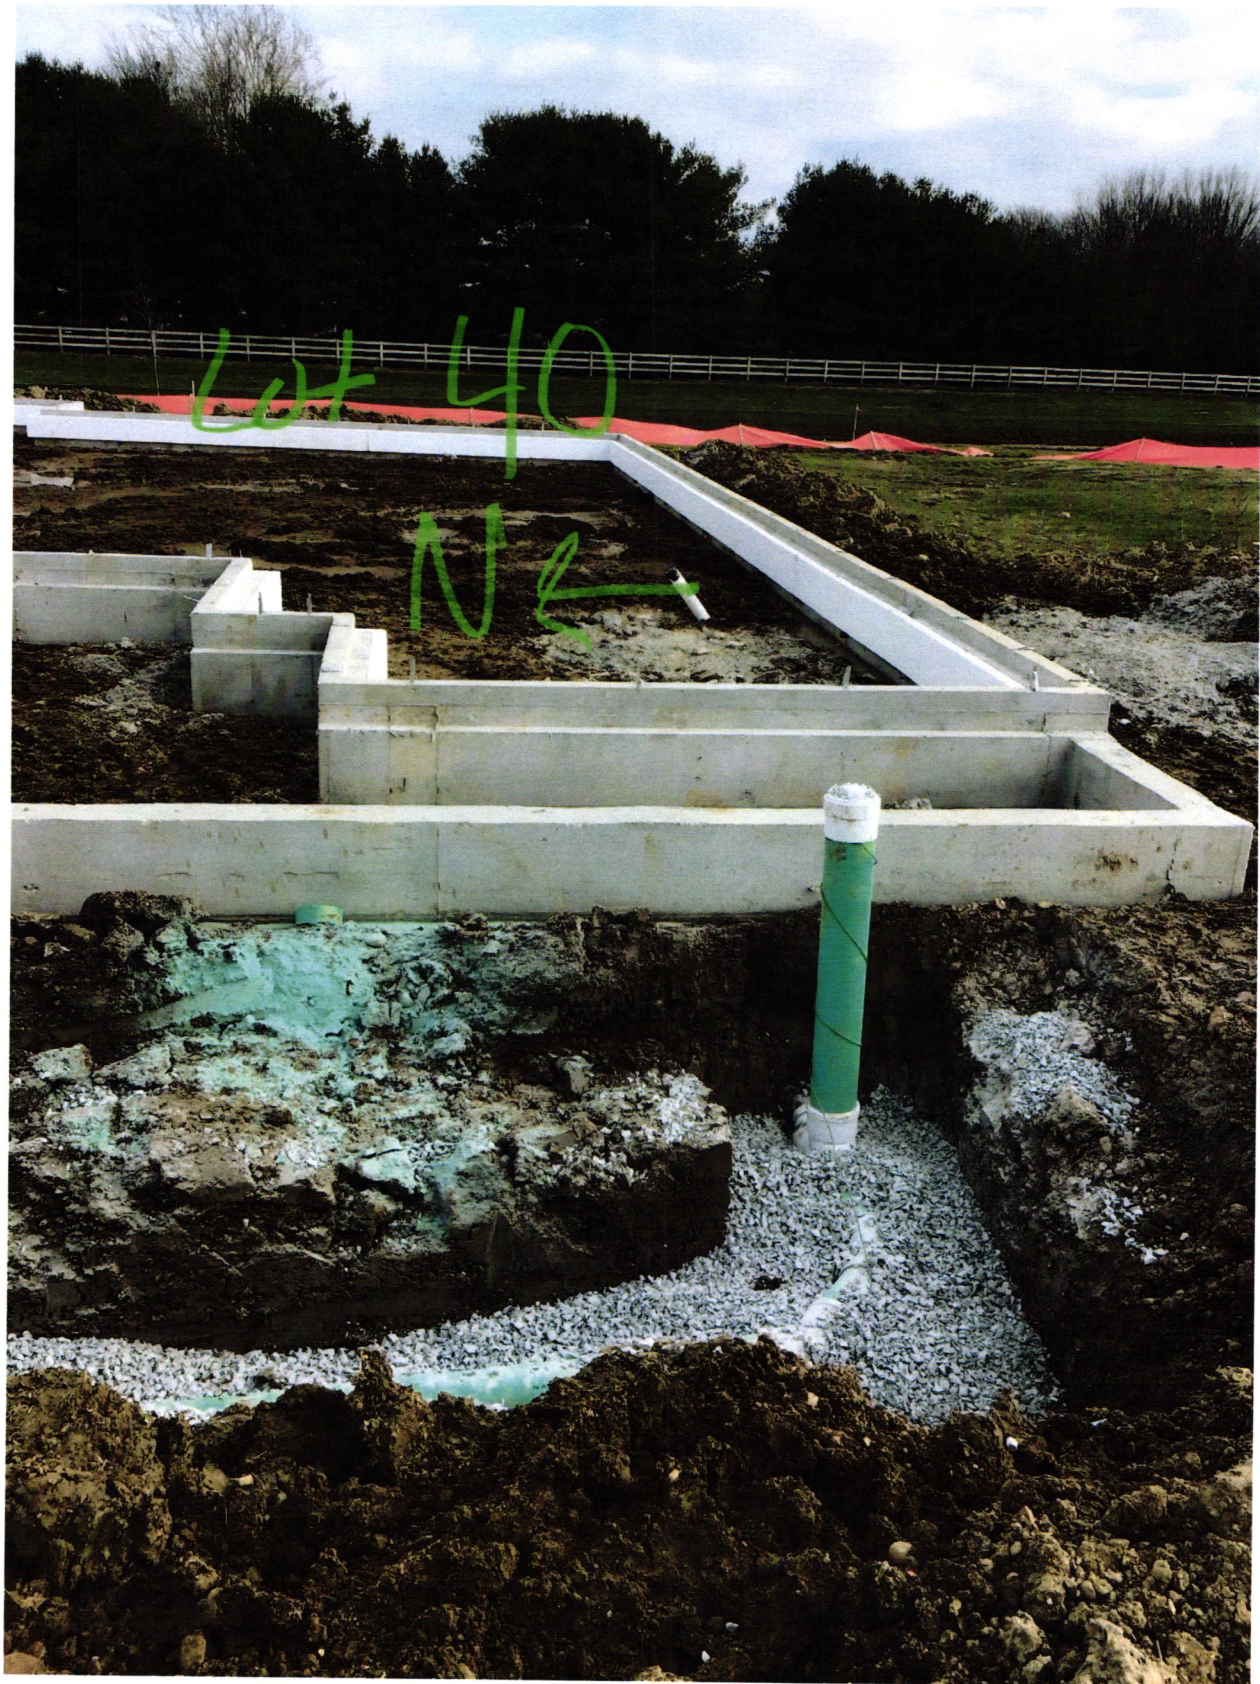



THIS CHECK HAS A COLORED BACKGROUND AND CONTAINS MULTIPLE SECURITY FEATURES - SEE BACK FOR DETAILS



CLAYTON PROPERTIES GROUP
ARBOR HOMES SILVERTHORNE HOMES

PERMIT ACCOUNT
9225 HARRISON PARK COURT
INDIANAPOLIS, IN 46216



71-65/749
First Merchants Bank
www.firstmerchants.com

046236

PAY
TO THE
ORDER OF

DATE 11/9/2021

Fall Creek Regional Waste District

\$ 760.00

Seven Hundred And Sixty Dollars And 0/100

DOLLARS

FOR

FALLS 40



BY:

NOT VALID FOR AMOUNTS OVER \$10,000

AUTHORIZED SIGNATURE

Rec # 011922