


Gidw.

PROJECT Phase II SHEET _____ OF _____

SUBJECT _____ DATE 8-4-18

JOB NO. 4447

BY Atlas

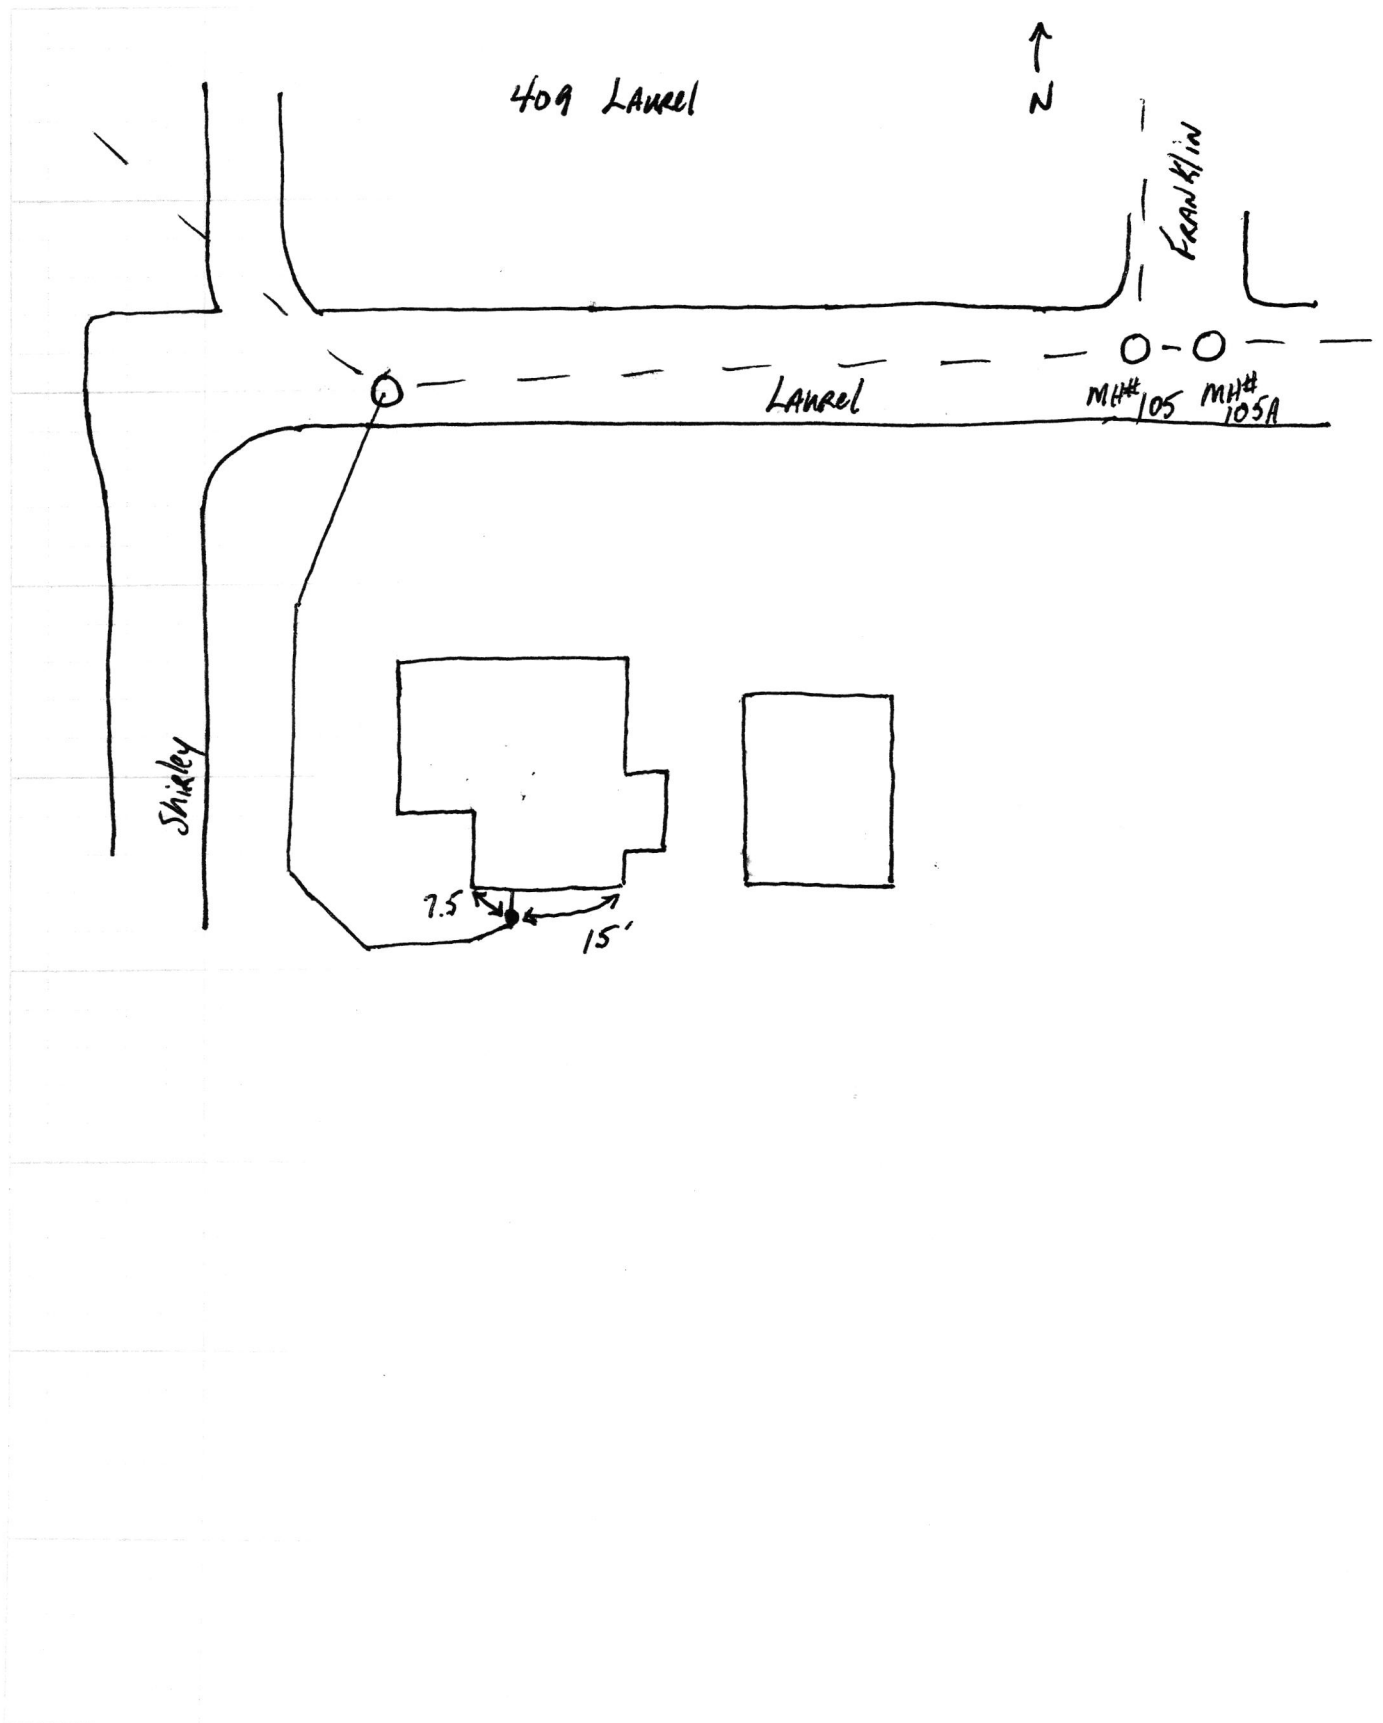



SKT Phase II

8.15.18