


Gidw.

PROJECT Phase II SHEET _____ OF _____

SUBJECT _____ DATE 8-10-18

JOB NO. 4447

BY Atlas

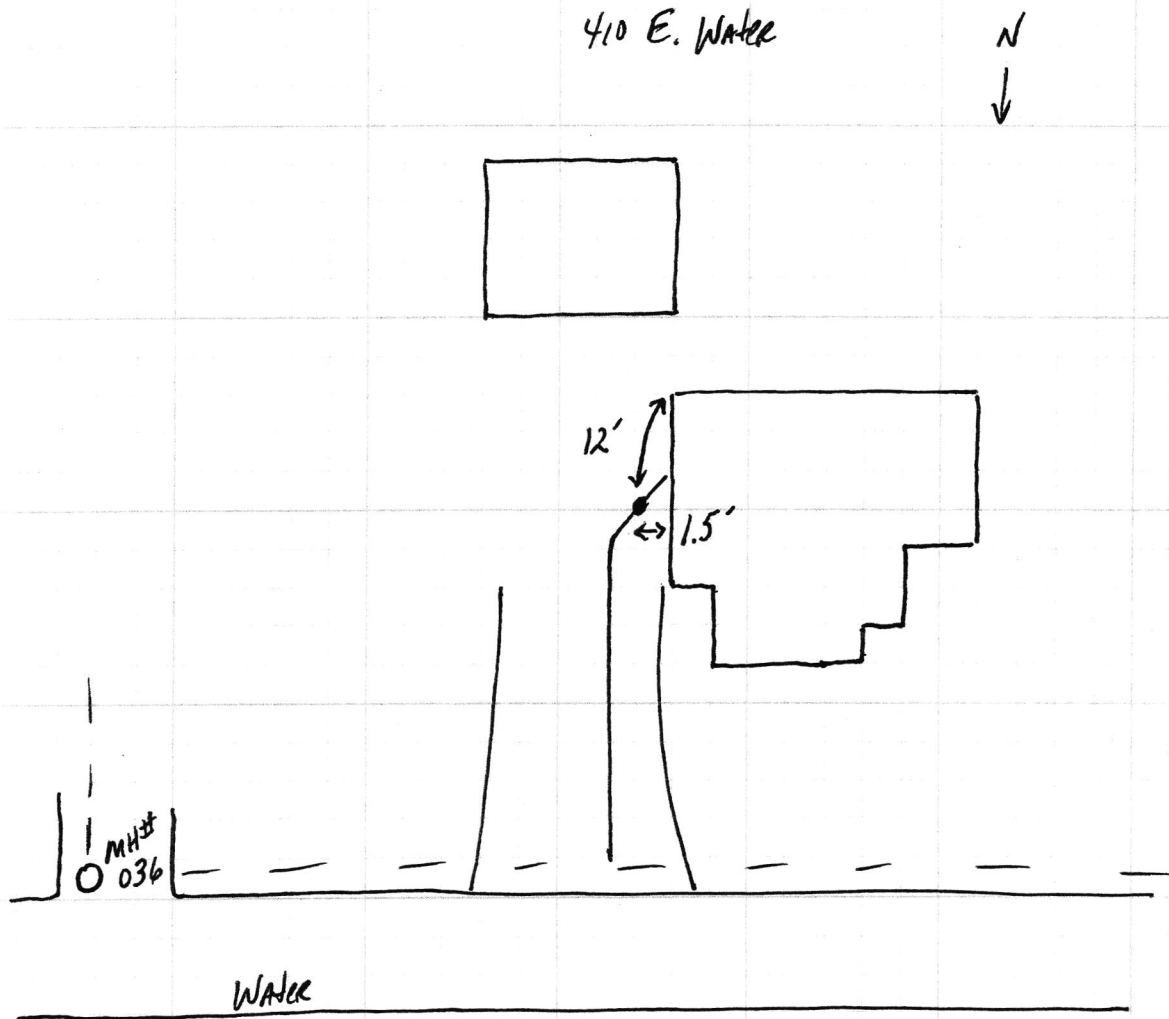

410 E Water

SRF Phase II

8-15-18

