


Gidw.

PROJECT Phase II SHEET _____ OF _____

SUBJECT _____ DATE 3-7-18

JOB NO. 4447

BY Atlas

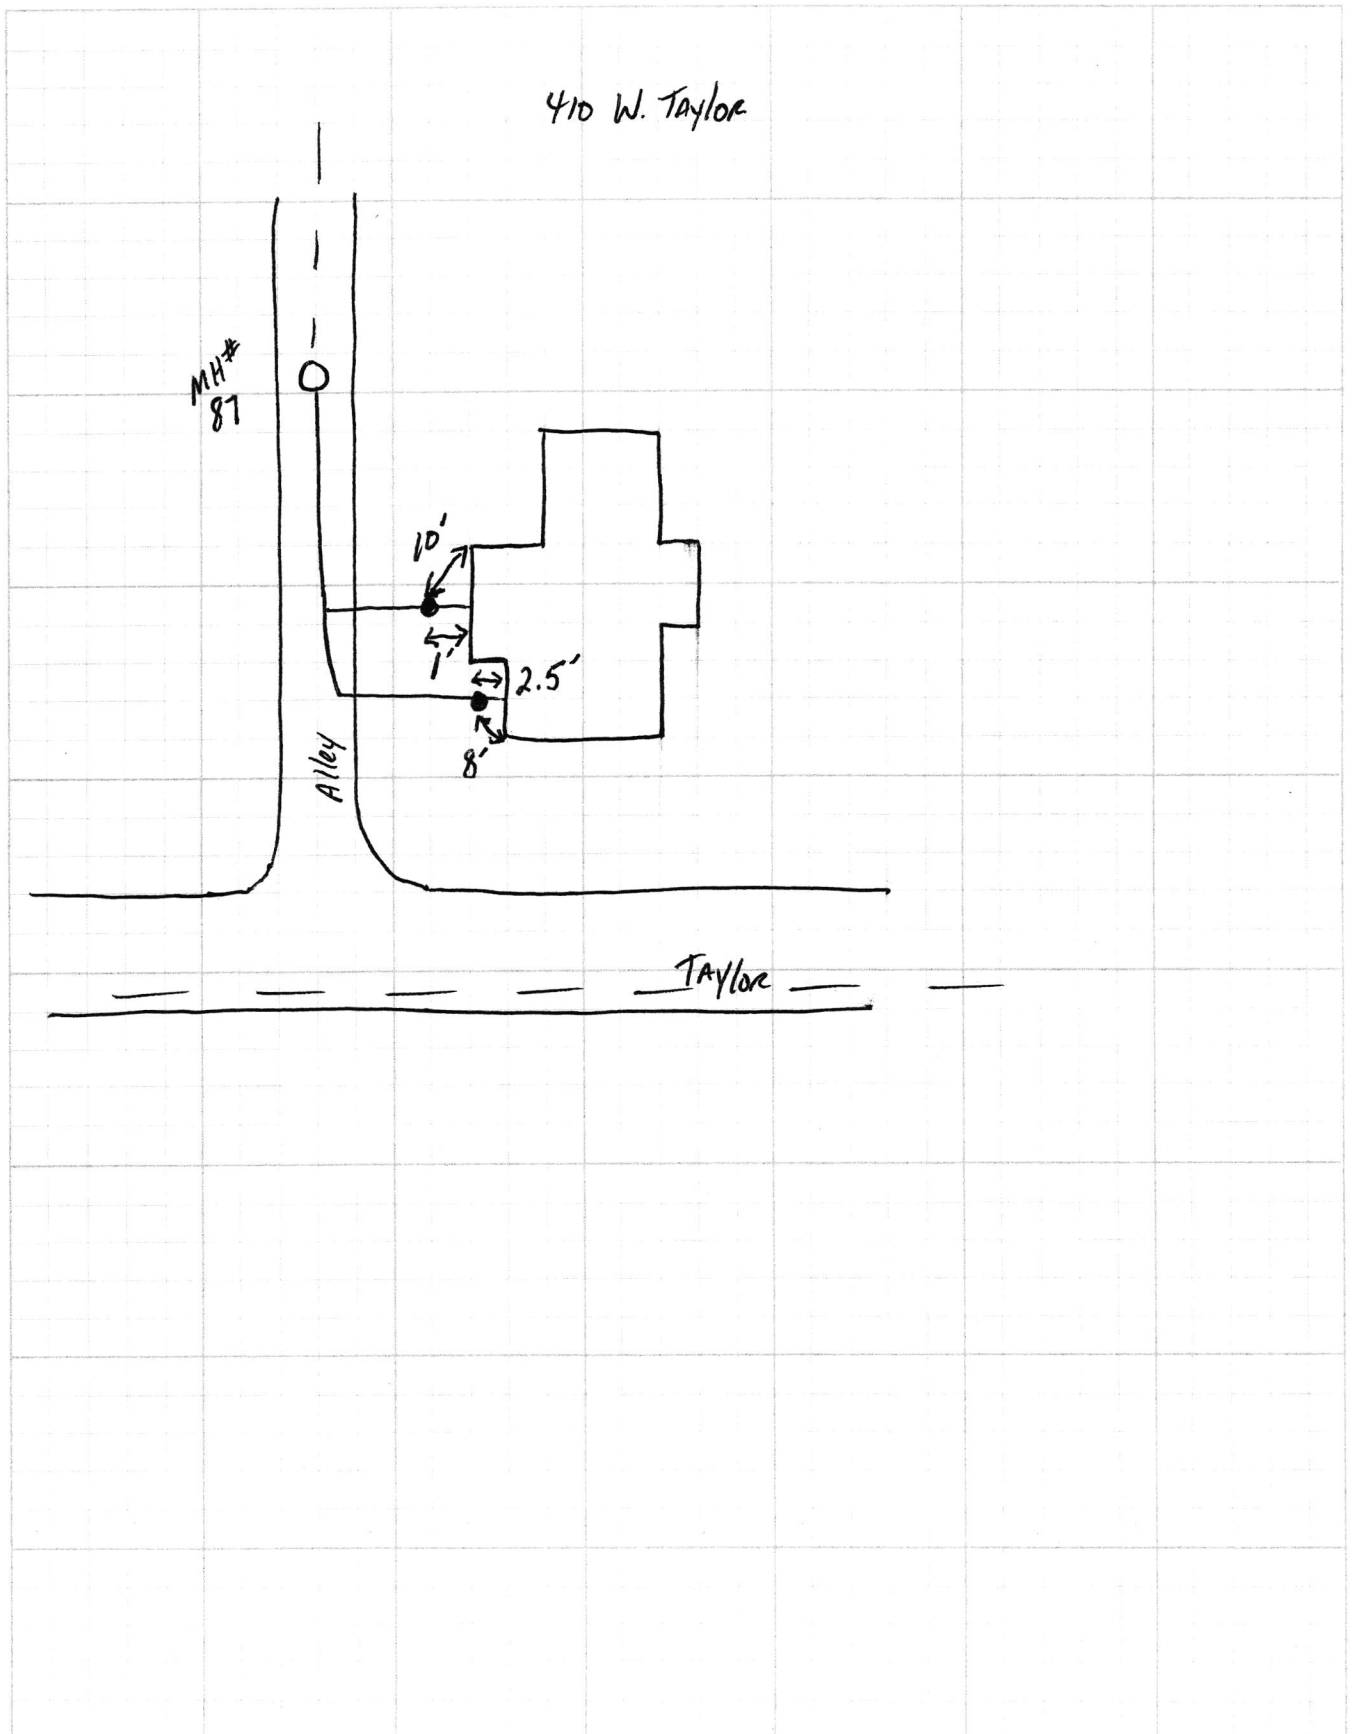

410 Taylor

SRP Phase II

