

Gidw.


PROJECT Phase II SHEET _____ OF _____

SUBJECT _____ DATE 3-23-18

JOB NO. 4447

BY Atlas

411 S. Pearl

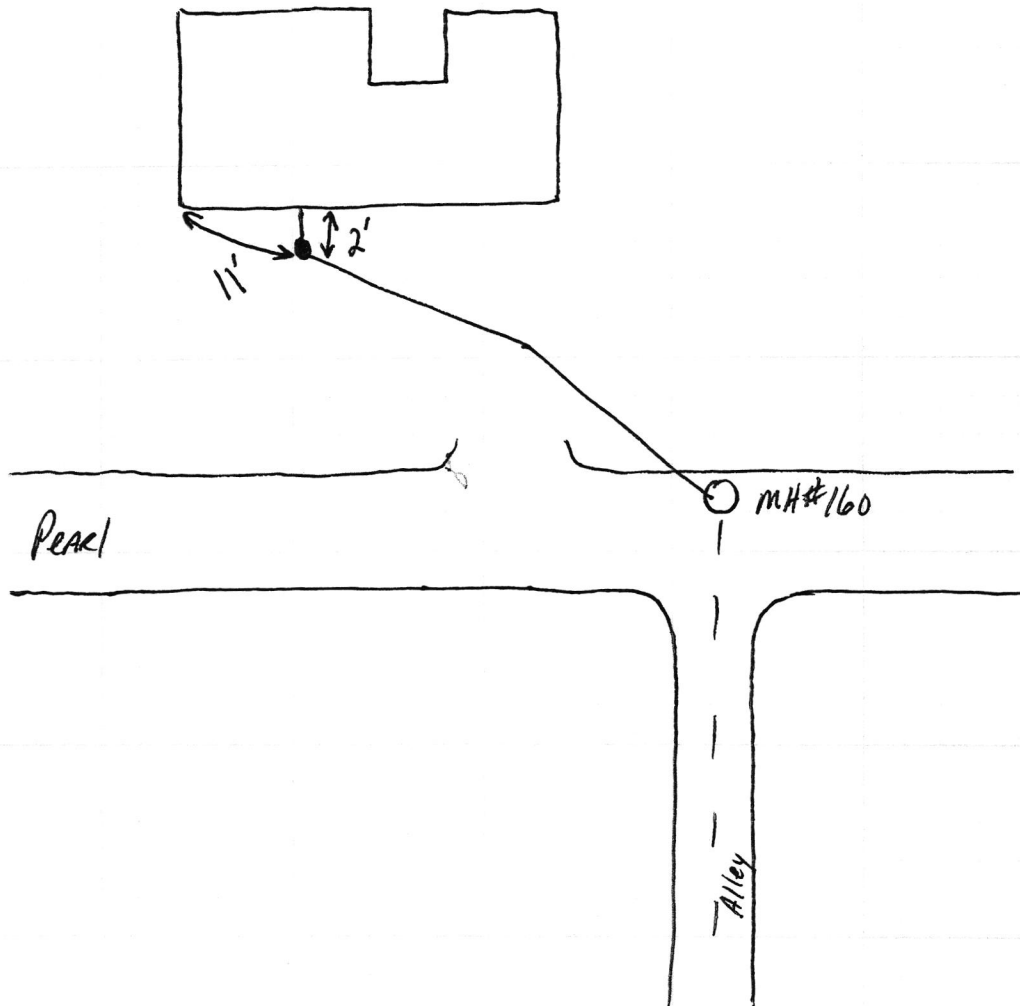

411 S Pearl

SRF Phase II

