


GIS

PROJECT Phase II SHEET _____ OF _____
SUBJECT _____ DATE 2-13-18
JOB NO. 4447
BY ALAS

411 W. Taylor

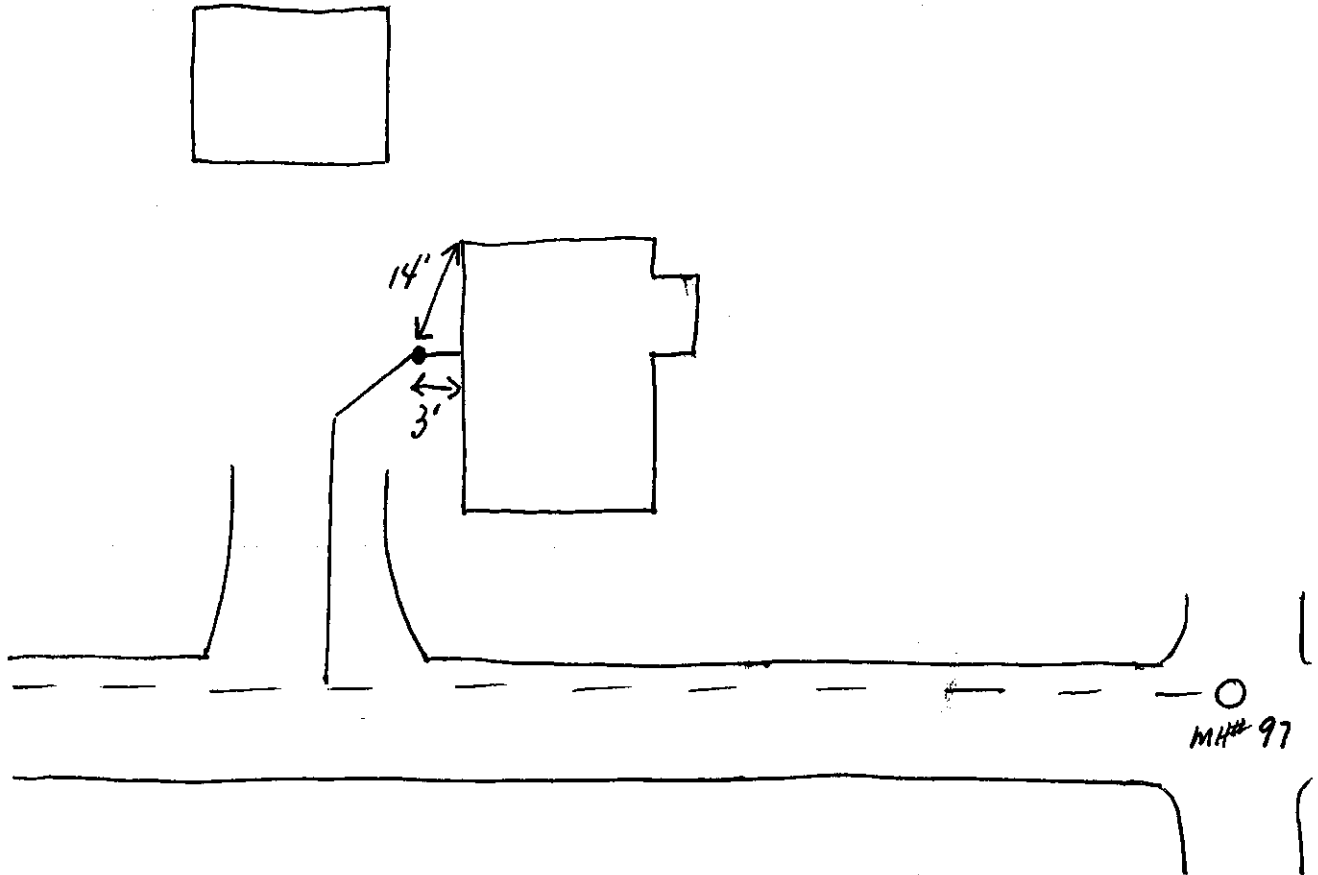

411 W Taylor

SFF Phase II

2.13.18

