

GLW


PROJECT Phase II SHEET _____ OF _____

SUBJECT _____ DATE 5-15-18

JOB NO. 4447

BY Atlas

413 S. Broadway

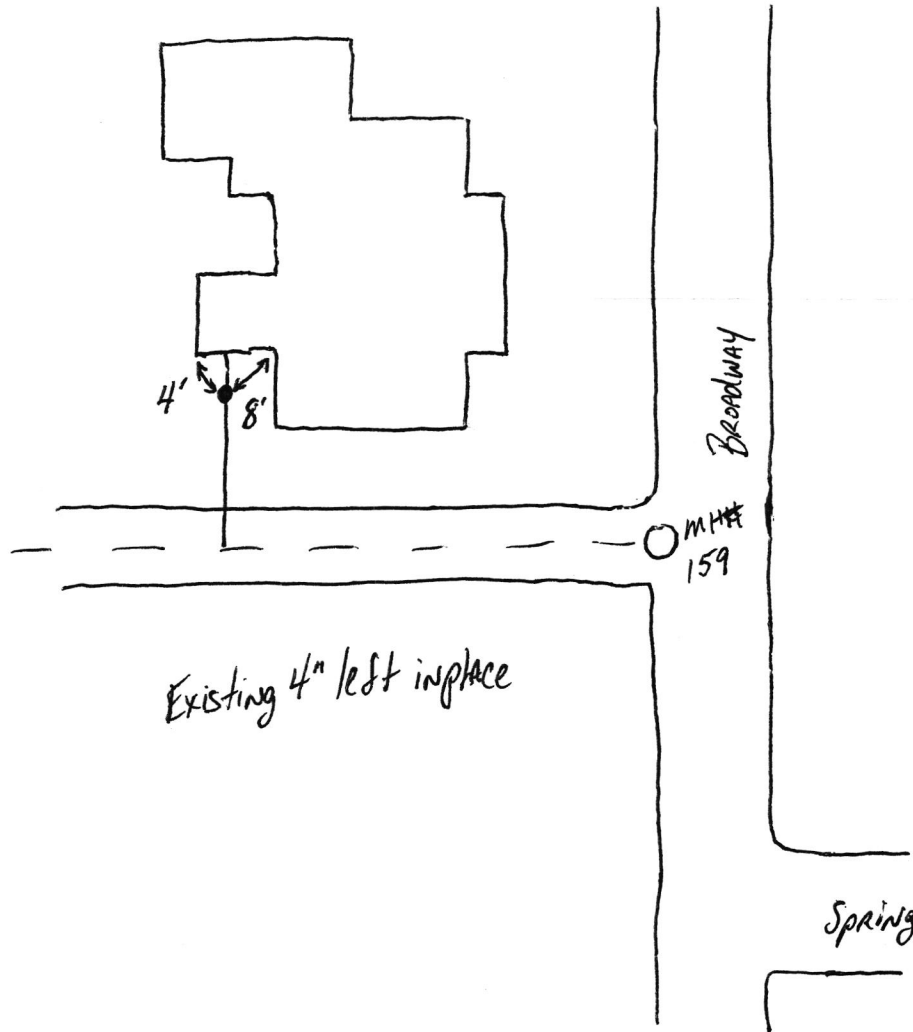

413 > Broadway

SF Phase II

5.22.18

